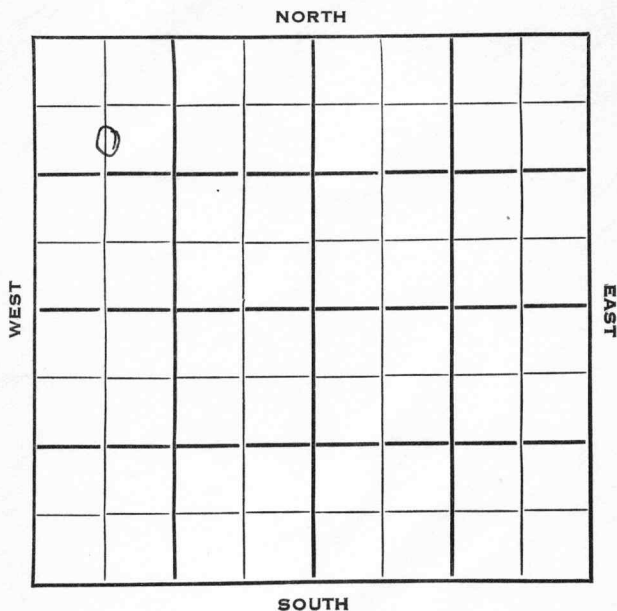


Section 29 Township 20 Range 10 EWell No. # 2 MohrCompany K & E D₁lg.

Lyon

KANSAS

SEC.	TWP.	R.
29	20	10E

WELL NO.

#2 Mohr

FARM

COMPANY

K & E Drlg.

CONTRACTOR


Berentz

990 _____ Ft. from N. Line

_____ Ft. from S. Line

_____ Ft. from E. Line

660 _____ Ft. from W. Line

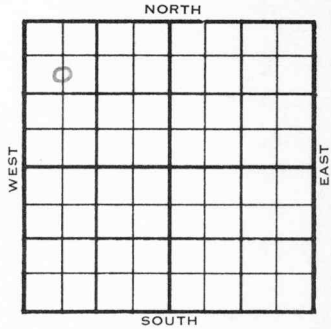

C S L NW NW

ELEVATION

REPORT

1953

11/30

Spud 11-30-53

8" @ 45'

WOC

12/22

Spud 11-30-53

Oil Well

TD 2323'

8" @ 45'

Lans 1445', KC 1712, B KC 1852'

Bart 2251', Cattleman Sd. 2271', Bart Sd 2313'

TD 2323'

5" @ 2314'

CO to 2323

Comp 8 bopd.

COMPLETED

County Lyons State Kansas

Sec. 29 (Blk. Twp.) 20 (Sur. Rge.) 10E Map No.

Operator K & E Drls.

Well No. 2 Farm Wehr

Elev.	Location
	C S L NW NW

990 Ft. From N Line NW

660 Ft. From W Line Quarter

1st. Report DEC 2 1953

Completion

Remarks


Berentz - Contr

Spudding Date 11-30-53

Drig. Data

8th@ 45 WOC

J. G. McGEHEE

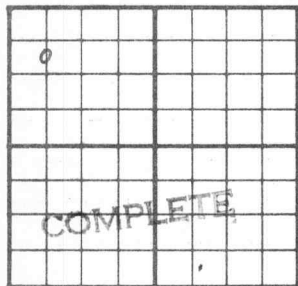County Lyon State KansasSec. 29 (Blk.
Twp.) 20 (Sur.
Rge.) 10E Map No.Operator K & E Drlg.Well No. 2 Farm MohrElev. Location C S L NW NW990 Ft. From N Line NW660 Ft. From W Line Quarter

1st. Report

Completion DEC 22 1953

Remarks

Berentz - Contr.Spudding Date 11-30-53Drlg. Data Oil well TD 23238" @ 45 Lans. 1445 KC 1712 B KC 1852Bart. 2251 Cattleman sd. 2271 Bart. sd.2313 TD 2323 5" @ 2314 CO to 2323Comp. 8 bopd