


Marion

KANSAS

SECTION 29 TOWNSHIP 20S RANGE 5E

WELL NO. #1 Barns

COMPANY White & Ellis

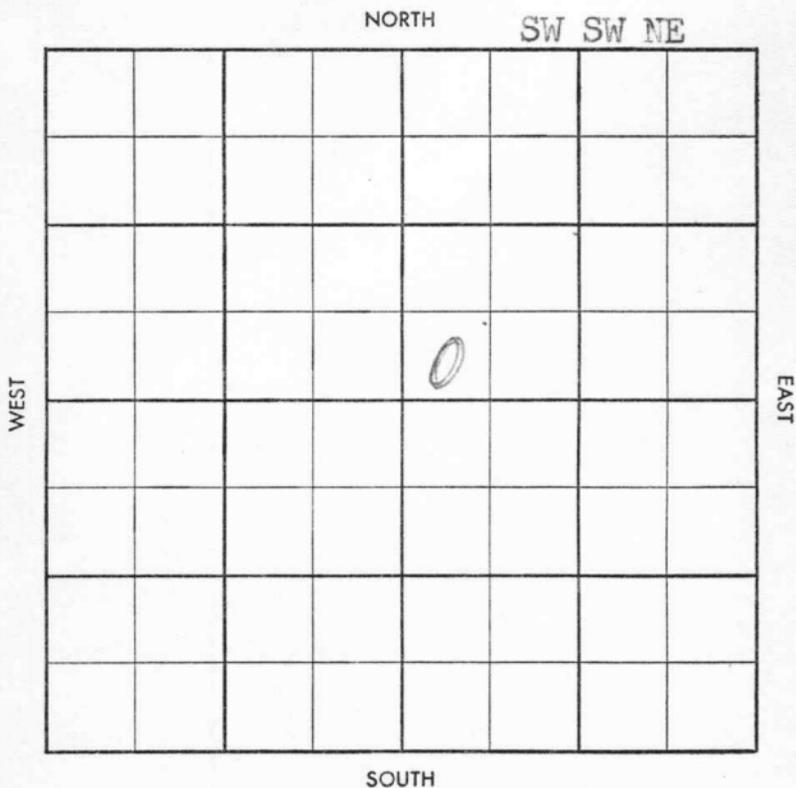



2021  
1353  
-668

S-513-A

CO. Marion ELEV. 1353 RB  
SEC. 29 TWP. 20 RGE. 5E  
COMPANY White & Ellis NO. 1

DEC 26 57

ABANDONED

FARM Berns  
LOC. SW SW NE


GEOL. \_\_\_\_\_  
 CONTR. Co. Tools #3  
 POOL Wildcat  
 SPUD 12-6-57  
 MIRT DEC 18 57  
8" 210/120 ~~XXXX~~  
~~2452~~ @ 2457  
DEC 26 57 ~~DST 2451~~  
LS 1674 B K L  
2021 CESD 2059

M 2208 K 2285 M 2  
 2449 Hunt 2452 ~~2451~~  
 MQ 2464 Via 2473 DST 2451  
 - 57 90" 70' MW 100' SW  
 FPO-85 BHP 865 130" 55K  
 2551 55D 2556 TD 2580  
 no log

DBA

CO.  
LSE.  
NO.  
SEC.  
TWP.  
RGE.