


Coffey

Map No. *Kansas* Sec. *29* Twp. *20* R. *17*

Well No. *1* *Pierson* Farm
O. J. Connell et al Company

NORTH

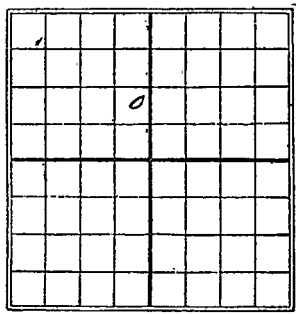

..... Ft. from N. Line

1120 Ft. from S. Line

200 Ft. from E. Line

..... Ft. from W. Line

Date *1926* REPORT

<i>3/31</i>	<i>Location</i>
<i>4/7</i>	_____
<i>4/15</i>	_____
<i>4/21</i>	_____
<i>4/28</i>	_____
<i>5/8</i>	<i>Same.</i>
<i>5/14</i>	_____
<i>5/19</i>	<i>machine</i>
<i>6/2</i>	<i>Spudding</i>
<i>6/10</i>	<i>same</i>
<i>6/18</i>	<i>Dlg 700</i>
<i>6/25</i>	<i>" 1420</i>
<i>6/30</i>	_____
<i>7/9</i>	<i>S. & A. 1529</i>

Coffey

Map No. *no map* **KANSAS** Sec. *29* Twp. *20* R. *17*

Well No. *1* *Richardson*

O. J. Connell Inc Company

Contractor

COMPLETED

SECTION PLAT

----- Ft. from N. Line

1120

Ft. from S. Line

200

Ft. from E. Line

Ft. from W. Line

ABANDONED

Location -----

Rig up -----

Drilling and Remarks:

Stand 1405-1428'
Top line 1498'
1st Bleeds 1522'
DRG 1529'

RECORD

Cased ----- in., ----- ft.

Sand -----

Gas -----

Oil -----

Total Depth *1529'*

PRODUCTION

1st 24 hrs. Nat. -----

1st 24 hrs. after shot -----

Gas ----- Cu. Ft.

Dry Hole

Abandoned

Date

JUL 9 1926

CHAS. L. SHERWOOD

192 Scout

Map No. *70 map* **KANSAS** Sec. *29* Twp. *20* R. *17*

Well No. *1 Richardson*

O J Cornell Et al Company

Contractor

FIRST REPORTS

SECTION PLAT

-----Ft. from N. Line

1120 Ft. from S. Line

200 Ft. from E. Line

-----Ft. from W. Line

	6		

Location

Rig up -----

Drilling and Remarks:

RECORD

Cased ----- in., ----- ft.

Sand -----

Gas -----

Oil -----

Total Depth -----

PRODUCTION

1st 24 hrs. Nat. -----

1st 24 hrs. after shot -----

Gas ----- Cu. Ft.

Dry Hole -----

Abandoned -----

Date

MAR 31 1926

CHAS. L. SHERWOOD

192

Scout