

marion

Form 51-5M-9-28-27423

Map No. **KANSAS** Sec. **30** Twp. **20** R. **4**

Well No. **1-Blunkley** Farm
Empire O & R. Company

NORTH

WEST

EAST

SOUTH

Location.....

Drilling Remarks

.....

.....

Rig Up.....

Drilling Remarks

.....

.....

RECORD

Cased..... in..... ft.

Sand.....

Gas.....

Oil.....

Total Depth.....

PRODUCTION

1st 24 hrs. Nat.....

1st 24 hrs. after shot.....

Gas..... cu. ft.....

Dry Hole.....

Abandoned.....


Map No. **KANSAS** Sec. **30** Twp. **20** R. **4**
Well No. **1-Blankley** Farm
Empire O & R. Company

330 Ft. from N. Line

..... Ft. from S. Line

990 Ft. from E. Line

..... Ft. from W. Line

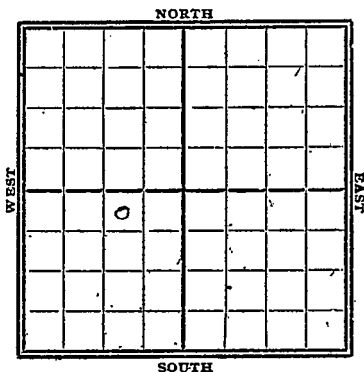

1928

Date	REPORT
12/12	Bldg Rig.
12/19	Re gging up
12/26	
1929	J
1/2	Spdg.
1/9	dry 600'
1/16	" 1247'
1/23	" 1900'
1/30	Top chat 2367'
	mg 8" at 2368'
2/6	Top chat 2367'
	B.L. 2418'
	Viola-2628-84'
	HFW-2672'
	T.D. 2684'
	dry & abandoned

Marion

A23 KANSAS Sec. *30* Twp. *20* R. *4*

Well No. *1* *Blandley*

Empire Oil Co Company

Contractor

FIRST REPORTS

SECTION PLAT

330 Ft. from N. Line

..... Ft. from S. Line

990 Ft. from E. Line

..... Ft. from W. Line

	<i>0</i>		

Location *Blossing*

Rig up *Blossing*

Drilling and Remarks:

RECORD

Cased.....in.,ft.

Sand.....

Gas.....

Oil.....

Total Depth.....

PRODUCTION

1st 24 hrs. Nat.....

1st 24 hrs. after shot.....

Gas.....Cu. Ft.

Dry Hole.....

Abandoned.....

Date
DEC 12 1928

CHAS. L. SHERWOOD

.....192..... Scout

Marion

Map No. **KANSAS** Sec. *30* Twp. *20* R. *4*
 Well No. *H23 1 Blankley*
Empire Oil Co Company

Contractor

COMPLETE

SECTION PLAT

330 Ft. from N. Line
 Ft. from S. Line
990 Ft. from E. Line
 Ft. from W. Line

	o		

ABANDONED

Location.....

Rig up.....

Drilling and Remarks:


RECORD

Cased.....in.,ft.
 Sand.....
 Gas.....
 Oil.....

PRODUCTION

1st 24 hrs. Nat.....
 1st 24 hrs. after shot.....
 Gas.....Cu. Ft.
 Dry Hole
 Abandoned

Date **FEB 6** 1929

CHAS. L. SHERWOOD
 192..... Scout