


Well No. 17 Melch Farm
Speedy et al Company

NORTH

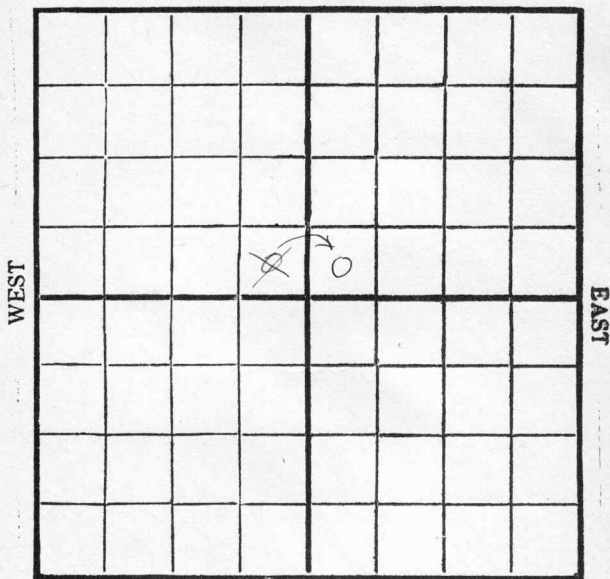

SOUTH

Location _____

Drilling Remarks

Rig Up _____

Drilling Remarks

RECORD

Cased _____ in. _____ ft.

Sand _____

Gas_____

Oil _____

Total Depth_____

PRODUCTION

1st 24 hrs. Nat. _____

1st 24 hrs. after shot_____


Gas _____ cu. ft. _____

Dry Hole_____

Abandoned _____

Lyon
 Map No. KANSAS Sec. 31 Twp. 20 R. 10^E
 Well No. 1- Melch Farm
Shady et al Company

_____ Ft. from N. Line
330 Ft. from S. Line
330 Ft. from E. Line
330 Ft. from W. Line
1930

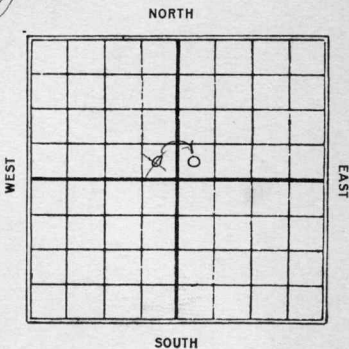

Date REPORT

10/29 Dry
 11/5 Dry
 11/12 Dry 800'
 11/19 " 1350'
 11/26 " 2035
 12/2 Land 2365-2404
 Show oil
 Sdy shale 2404-50
 Top lime 2482
 1/2 barrel water at 2492
 T.D. 2555
 dry & abandon

Map No. KANSAS Sec. 31 Twp. 20 R. 10 ^E

Well No. 1 Welch

Sheedy & Co Company

Contractor

FIRST REPORTS

Ft. from N. Line

330 Ft. from S. Line

330 Ft. from E. Line

Ft. from W. Line

SECTION PLAT

Location

Rig up ☒

Drilling and Remarks:

RECORD

Cased _____ in., _____ ft.

Sand _____

Gas _____

Oil _____

Total Depth _____

PRODUCTION

1st 24 hrs. Nat. _____

1st 24 hrs. after shot _____

Gas _____ Cu. Ft.

Dry Hole _____

Abandoned _____

Date

OCT 29 1930

192 CHAS. L. SHERWOOD

Scout

Map No. *KANSAS* Sec. *31* Twp. *20* R. *10* ^E


Well No. *1* *Welch*

Sheedy & al Company

Contractor

CORRECTION

SECTION PLAT

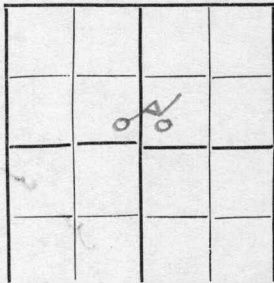

.....Ft. from N. Line

330 Ft. from S. Line

.....Ft. from E. Line

330 Ft. from W. Line

Location.....

Rig up.....

Drilling and Remarks:

chgy Location

RECORD

Cased.....in.,ft.

Sand.....

Gas.....

Oil.....

Total Depth.....

PRODUCTION

1st 24 hrs. Nat.....

1st 24 hrs. after shot.....

Gas.....Cu. Ft.

Dry Hole.....

Abandoned.....

Date

NOV 5 1930

CHAS. L. SHERWOOD

192.....

Scout

KANSAS

Map No. _____ Sec. 31 Twp. 20 R. 10Well No. 1 WelchSheedy et al Company

Contractor

COMPLETE

SECTION PLAT

		0	

_____ Ft. from N. Line

330 Ft. from S. Line

_____ Ft. from E. Line

330 Ft. from W. Line

ABANDONED

Location _____

Rig up _____

Drilling and Remarks:

Sand 2365-2404
Show oil

Sandy shale 2404-50
Tap lime 2482

1/2 BW 2492

RECORD

Cased _____ in., _____ ft.

Sand _____

Gas _____

Oil _____

Total Depth 2555

PRODUCTION

1st 24 hrs. Nat. _____

1st 24 hrs. after shot _____

Gas _____ Cu. Ft.

Dry Hole ☒Abandoned ☒

Date

DEC 3 1930 CHAS. L. SHERWOOD

192 _____ Scout