


Marion

KANSAS  
5E

Section 31 Township 20 Range 5E

Well No. #1 Robinson

Company Raymond Gear et al

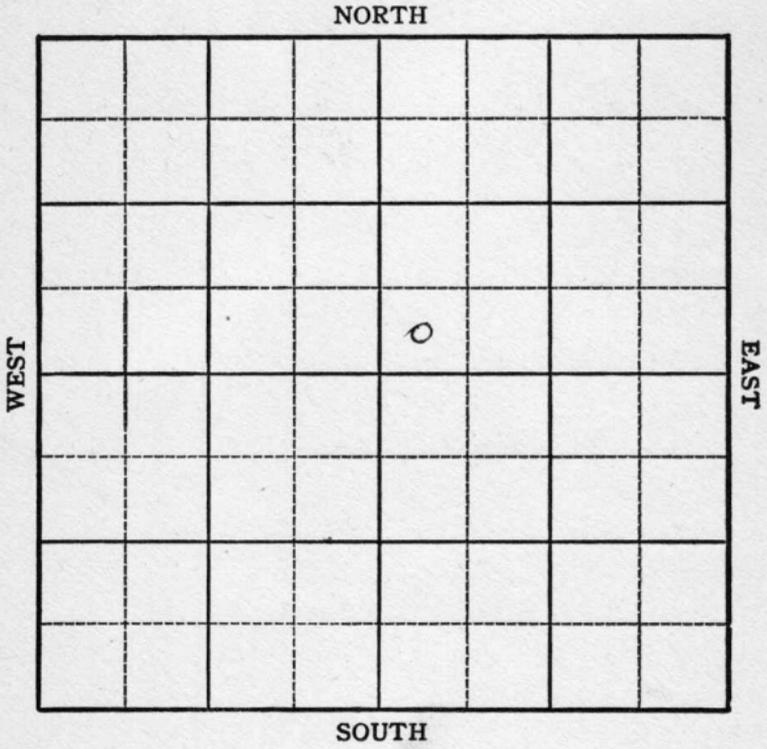

Sec. 31 Twp. 20 R. 5-E

Well No. #1 Robinson Farm

Raymond Gear et al Company

Contractor


Ft. from N. Line

330 Ft. from S. Line

Ft. from E. Line

330 Ft. from W. Line

SW SW NE

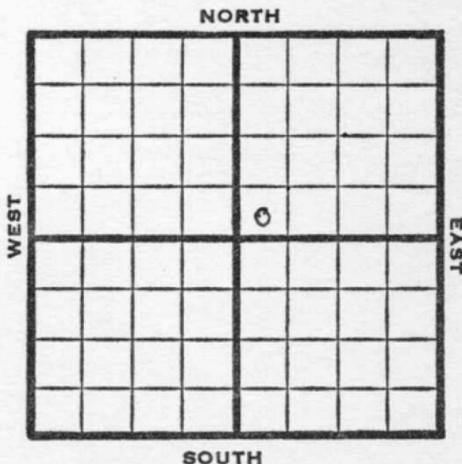

1950

Elev. 1403' REPORT

3/22  
6/7

Drlg 30'  
10" @ 175'  
Miss 2282'  
7" @ 2558'  
Viola 2561'  
18 BOPD  
TD 2566'

**COMPLETED**

Map No. \_\_\_\_\_ Sec. 31 Twp. 20 R. 5E

Well No. 1 Robinson

Raymond Gear et al. Company

Contractor

SW SW NE


\_\_\_\_\_ Ft. from N. Line

330 Ft. from S. Line

\_\_\_\_\_ Ft. from E. Line

330 Ft. from W. Line

SECTION PLAT

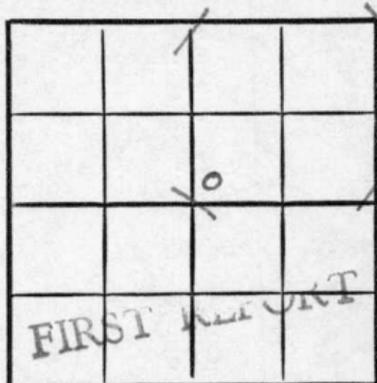

Marion County

Location \_\_\_\_\_

Rig up \_\_\_\_\_

Drilling and Remarks:

drlg. 30'

RECORD

Cased \_\_\_\_\_ in., \_\_\_\_\_ ft.

Sand \_\_\_\_\_

Gas \_\_\_\_\_

Oil \_\_\_\_\_

Total Depth \_\_\_\_\_

PRODUCTION

1st 24 hrs. Nat. \_\_\_\_\_

1st 24 hrs. after shot \_\_\_\_\_

Gas \_\_\_\_\_ Cu. Ft.

Dry Hole \_\_\_\_\_

Abandoned \_\_\_\_\_

Date

MAR 22 1950

19

J. E. TYRA Scout

Kansas

Map No. \_\_\_\_\_ Sec. 31 Twp. 20 R. 5E

Well No. 1 Robinson

Raymond Gear et al Company

Contractor

SW SW NE

E1.1403  
SECTION PLAT

\_\_\_\_\_ Ft. from N. Line

330 Ft. from S. Line

\_\_\_\_\_ Ft. from E. Line

330 Ft. from W. Line

COMPLETE			
		o	

Marion

Location \_\_\_\_\_

Rig up \_\_\_\_\_

Drilling and Remarks:

*10" @ 175*  
*Miss 2282*  
*7" @ 2558*  
*Viola 2561*  
*18 BOPD*

RECORD

Cased \_\_\_\_\_ in., \_\_\_\_\_ ft.

Sand \_\_\_\_\_

Gas \_\_\_\_\_

Oil \_\_\_\_\_

Total Depth 2566

PRODUCTION

1st 24 hrs. Nat. \_\_\_\_\_

1st 24 hrs. after shot \_\_\_\_\_

Gas \_\_\_\_\_ Cu. Ft.

Dry Hole \_\_\_\_\_

Abandoned \_\_\_\_\_

Date

JUN 7 1950 19

J. E. TYRA Scout