



Map No. Kansas Sec. 31 Twp. 20 R. 11

Well No. 1 Rice Farm


Ritchie + Moore Company

\_\_\_\_\_ Ft. from N. Line

1120 Ft. from S. Line

\_\_\_\_\_ Ft. from E. Line

200 Ft. from W. Line

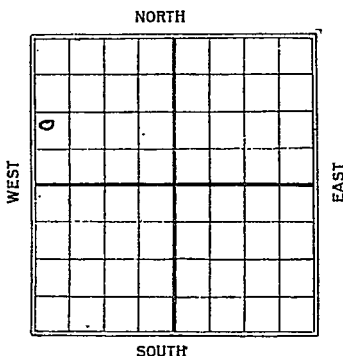

Charles

Date	REPORT
1925	
5/15	Location
5/29	_____
6/5	_____
6/12	_____
6/18	_____
6/26	_____
7/3	_____
7/10	_____
7/17	_____
7/24	_____
7/31	_____
8/7	_____
8/14	640
8/19	_____
8/26	1520
9/3	_____
9/11	_____
9/24	1 Hrly @ 400'
10/7	Sand 2007-2010 Hrly 2500
10/8	Top Line @ 2167. TTT 2320 & L.R.

10/16 SW. @ 2350

10/22 W. @ 2510

10/29 - Abandoned 2610

Lyon Co

K21 KANSAS Map No. Sec. 31 Twp. 20 R. 11

Well No. 1 Bico  
Betcher & Moore Company

Contractor

COMPLETED

SECTION PLAT

\_\_\_\_\_ Ft. from N. Line

1120 Ft. from S. Line

\_\_\_\_\_ Ft. from E. Line

200 Ft. from W. Line

o			

ABANDONED

Location \_\_\_\_\_

Rig up \_\_\_\_\_

Drilling and Remarks:

AD 2007-2010 Dry  
Top line 2164  
Dry & etc  
T.D. 2610 HFW

RECORD

Cased \_\_\_\_\_ in., \_\_\_\_\_ ft.

Sand \_\_\_\_\_

Gas \_\_\_\_\_

Oil \_\_\_\_\_

Total Depth 2610

PRODUCTION

1st 24 hrs. Nat. \_\_\_\_\_

1st 24 hrs. after shot \_\_\_\_\_

Gas \_\_\_\_\_ Cu. Ft.

Dry Hole ✓

Abandoned ✓

Date

OCT 29 1925

CHAS. L. SHERWOOD

192

Scout



Map No. 24 Maps Sec. 31 Twp. 20 R. 11

Well No. 1 Rice

Ritchie & Moore Company

Contractor

FIRST REPORTS

SECTION PLAT

\_\_\_\_\_ Ft. from N. Line

1/20 Ft. from S. Line

\_\_\_\_\_ Ft. from E. Line

200 Ft. from W. Line

6			

Location

Rig up \_\_\_\_\_

Drilling and Remarks:

RECORD

Cased \_\_\_\_\_ in., \_\_\_\_\_ ft.

Sand \_\_\_\_\_

Gas \_\_\_\_\_

Oil \_\_\_\_\_

Total Depth \_\_\_\_\_

PRODUCTION

1st 24 hrs. Nat. \_\_\_\_\_

1st 24 hrs. after shot \_\_\_\_\_

Gas \_\_\_\_\_ Cu. Ft.

Dry Hole \_\_\_\_\_

Abandoned \_\_\_\_\_

Date  
MAY 15 1925

CHAS. L. SHERWOOD  
Scout

100

1

100

100

100



100

100

Returned	
Cards	<i>RM</i>
Tracing	<i>RM</i>
France Map	<i>RM</i>
Scarborough Map	<i>RM</i>
Moody Map	
Scarborough Plat Book	
Moody Plat Book	