


Section 32 Township 20 Range 11E

Well No. #1 Hellmer

Company Helmerich & Payne Inc.

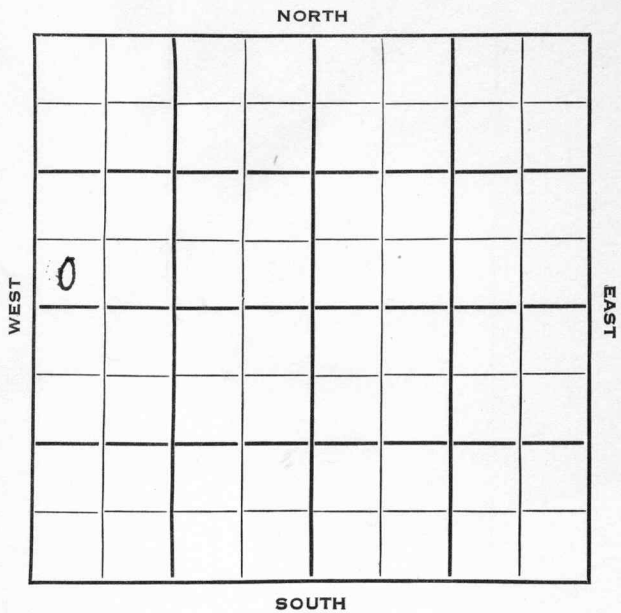

KANSAS

Lyon
20

Sec. 32 Twp. R. 11E

Well No. #1 Hellmer Farm

Helmerich & Payne, Inc. Company

Brack Drlg. Contractor

Wildcat

Ft. from N. Line


330 Ft. from S. Line

Ft. from E. Line

330 Ft. from W. Line

SW SWNW

Shell-\$6000-DHM

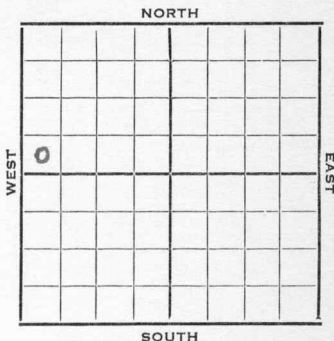

1953 Elev. 1245' REPORT


7/8 Location

7/29 Spud 7-10-53 D & A TD 2742
8" @ 92 Lans 1088
DST 1077-1123 open 1½ hr rec 66' SOCM
320# KC 1379
DST 1355-1400 open ½ hr rec 10' mud
320# B KC 1498 Marm 1633
Miss 2126 Hunton 2570 Viola 2614
Simp. 2638 Arb. 2692'
TD 2742'
D & A

ABANDONED

1498
1245
-253

County Lyon State Kansas
 Sec. 32 (Blk.) 20 (Sur.) 11E Map No.
 Operator Helmerich & Payne
 Well No. 1 Farm Hellmer
 Elev. 1245 Location SW SW NW

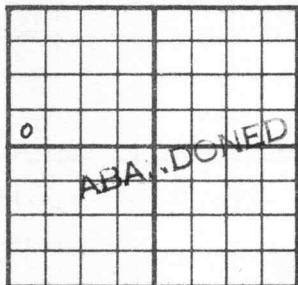

330 Ft. From S Line NW
330 Ft. From W Line Quarter

1st. Report

Completion JUL 29 1953

Remarks Wildcat

Brack - Contr.

Spudding Date 7-10-53

Drig. Data D & A TD 2742

8" @ 92 Lans. 1088 DST 1077-1123

open 1½ hr. Rec. 66' socm 320#

KC 1379 DST 1355-1400 open ½ hr.

Rec. 10' mud 320# B KC 1498

Marm. 1633 Miss. 2126 Hunton 2570

Viola 2614 Simp. 2638 Arb. 2692

TD 2742

D & A

J. G. McGENEE

County Lyons State Kansas

Sec. 32 (Blk. 20 (Sur. 11E Map No.

Operator **Helmerich & Payne Inc.**

Well No. **1** Farm **Hellmer**

Elev.	Location	SW SW NW
-------	----------	----------

330 Ft. From S Line NW

330	Ft. From	W Line	Quarter
-----	----------	--------	---------

1st. Report JUL 8 1953

Completion

Remarks Shell-\$6000-DHM

Brack Drlg. - Contr.

Spudding Date _____

Drig. Data Wildcat

J. G. McGEHEE