

Map No. Kansas Sec. 32 Twp. 20 R. 12

Well No. 1 Scott Farm
Gasche & Bellier Company


NORTH

200 Ft. from N. Line

_____ Ft. from S. Line

_____ Ft. from E. Line

200 Ft. from W. Line

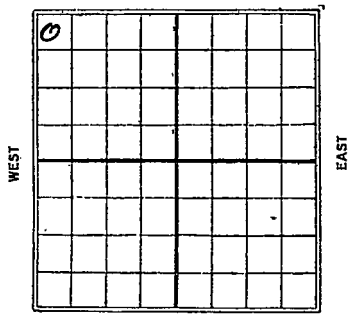

1926

Date	REPORT
2/10	<u>Location</u>
2/17	_____
2/24	_____
3/5	_____
3/10	_____
3/15	_____
3/25	_____
4/1	_____
4/7	_____
4/15	_____
4/21	_____
4/28	_____
5/8	<u>Same.</u>
5/14	_____
5/19	<u>Same.</u>
6/2	<u>Same</u>
6/10	_____
6/18	_____
6/25	_____
6-26	_____
7/8	_____
7/15	_____

7/22 - location
 7/28 _____
 8/4 _____
 8/11 _____
 8/18 _____
 8/25 _____
 8-31 _____
 9/16 _____
 9/22 _____
 9/29 - same
 10/3 _____
 10/27 _____
 11/11 - Rig
 11/17 - same
 11/23 - Spud 150'
 12/8 - Drlg 680
 12/15 - " 740'
 12/22 - S.D. 740
 12/30 _____
 1927
 1/6 _____
 1/13 _____
 1/19 _____
 1/26 _____
 2/3 _____
 2/10 _____
 2/17 _____
 2/24 - Drlg 850
 3/2 - " 1160
 3/9 - S.D. 1160
 3/16 - fishing 1200
 3/24 - Drlg 1210
 3/30 - " 1600
 4/7 - " 1700
 4/16 - Top Miss. 1838 - T.D. 1915

1927

4/20 - Top line
1838

D. & A. 1915

no V.V. sand

Hyons Co

KANSAS

32

Twp. 20

R. 13

Map No. _____

Sec. _____

Twp. _____

R. _____

Well No. _____

1 Scott
Gibbs & Belliere

Company

Contractor

SECTION PLAT

200

Ft. from N. Line

Ft. from S. Line

Ft. from E. Line

200

Ft. from W. Line

0			

FIRST REPORTS

Location ✓ _____

Rig up _____

Drilling and Remarks:

RECORD

Cased _____ in., _____ ft.

Sand _____

Gas _____

Oil _____

Total Depth _____

PRODUCTION

1st 24 hrs. Nat. _____

1st 24 hrs. after shot _____

Gas _____ Cu. Ft.

Dry Hole _____

Abandoned _____

Date

FEB 10 1926

192

CHAS. L. SHERWOOD

Scout

Returned	
Cards	<i>BB</i>
Tracing	<i>D. W. map</i>
France Map	<i>and map</i>
Scarborough Map	<i>B</i>
Moody Map	
Scarborough Plat Book	
Moody Plat Book	

No wall map

non **KANSAS**

lyon

Map No. *1* Sec. *32* Twp. *20* R. *13*

Well No. *1* *Scott*

Boche & Belliere Company

Contractor

COMPLETED

SECTION PLAT

300 Ft. from N. Line

Ft. from S. Line

Ft. from E. Line

200 Ft. from W. Line

o			

ABANDONED

Location -----

Rig up -----

Drilling and Remarks:

Top lens 1838'

Dec 1915

No boils and

RECORD

Cased ----- in., ----- ft.

Sand -----

Gas -----

Oil -----

Total Depth *1915'*

PRODUCTION

1st 24 hrs. Nat. -----

1st 24 hrs. after shot -----

Gas ----- Cu. Ft.

Dry Hole

Abandoned

Date *APR 20 1927*

192

CHAS. L. SHERWOOD

Scout

