


Section 36 Township 20 Range 4-E

Well No. #1 DeForrest

Company Basco Drlg. etal

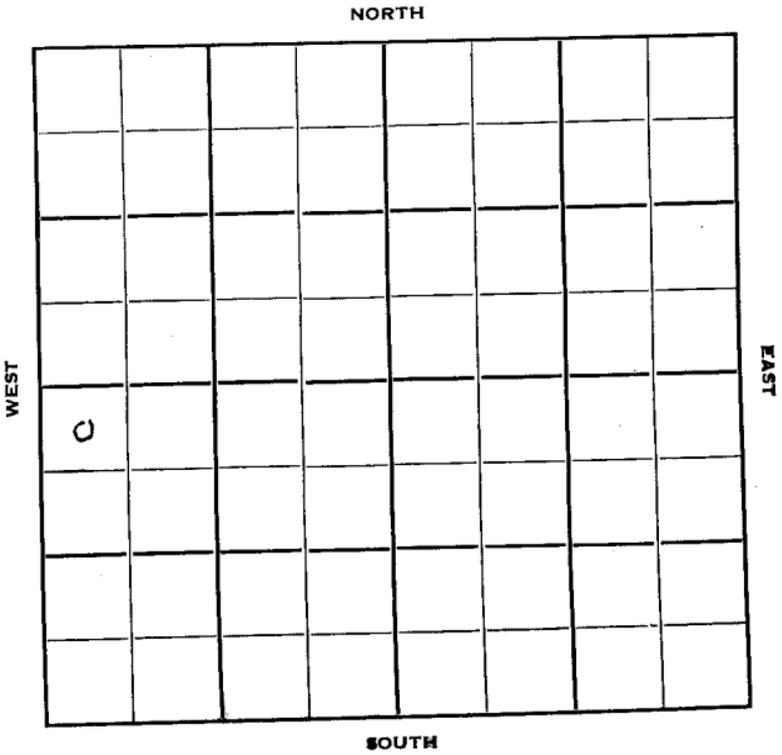

Marion KANSAS  
4E

Sec. 36 Twp. 20 R.

Well No. #1 DeForrest Farm

Basco Drlg. et al Company

Contractor

Wildcat


330' Ft. from N. Line

Ft. from S. Line

Ft. from E. Line

330' Ft. from W. Line

NW NW SW

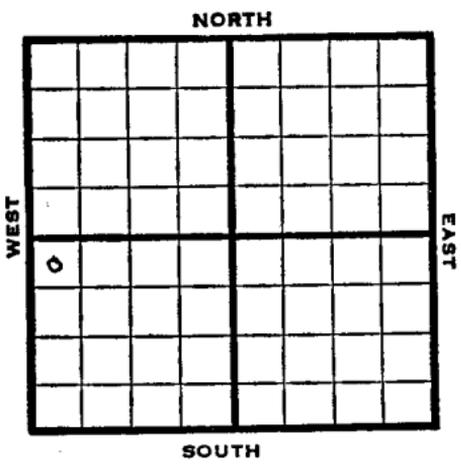

1950

Elv. 1364'

REPORT

9/6

RUR

9/20

Spud 9-6-50

8" @ 174

Miss chat 2270

Kinderhook 2395

Viola 2564

TD 2585

D&A

ABANDONED.

County Marion State Kansas

Sec. 36 (Blk. Twp.) 20 (Sur. Rge.) 4E Map No.

Operator Basco Drlg. etal.

Well No. 1 Farm DeForrest

Elev. 1364 Location NW NW SW

o					

330 Ft. From N Line SW

330 Ft. From W Line Quarter

1st. Report SEP 6 1950

Completion \_\_\_\_\_

Remarks \_\_\_\_\_

\_\_\_\_\_

Spudding Date \_\_\_\_\_

Drlg. Data Wildcat

RUR

J. E. TYRA

