

Kansas

Wildcat

Map No. _____ Sec. 14 Twp. 20 R. 9E


Well No. 1 Piper

Mendenhall Drlg. _____ Company

Contractor

SW 1/4 NW

SECTION PLAT

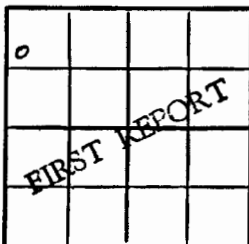

990 Ft. from N. Line

_____ Ft. from S. Line

_____ Ft. from E. Line

330 Ft. from W. Line

Chase County

Location _____

RECORD

Cased _____ in. _____ ft.

Sand _____

Gas _____

Oil _____

Total Depth _____

PRODUCTION

1st 24 hrs. Nat. _____

1st 24 hrs. after shot _____

Gas _____ Cu. Ft.

Dry Hole _____

Abandoned _____

Rig up _____

Drilling and Remarks:

8 5/8" C 65

WOC

Date

APR 5 1950 19

J. E. TYRA

Scout

Kansas

Wildcat

Map No. _____ Sec. 14 Twp. 20 R. 9E


Well No. 1 Piper

Mendenhall Drlg. _____ Company

Contractor

El. 1356

SECTION PLAT

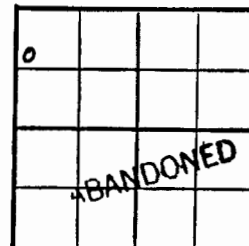

990 Ft. from N. Line

_____ Ft. from S. Line

_____ Ft. from E. Line

330 Ft. from W. Line

Chase

Location _____

RECORD

Cased _____ in. _____ ft.

Sand _____

Gas _____

Oil _____

Total Depth 2468

PRODUCTION

1st 24 hrs. Nat. _____

1st 24 hrs. after shot _____

Gas _____ Cu. Ft.

Dry Hole _____

Abandoned _____

Rig up _____

Drilling and Remarks:

8 5/8" C 65

5" C 2308

Neub. 1105

Lans. 1453

Cherokee 2115

Bart. 2309-49

Date

MAY 31 1950

19 J. E. TYRA Scout


Burgess 2437

Miss. 2454

DST 2310-2425

Rec. mud NS

D + A

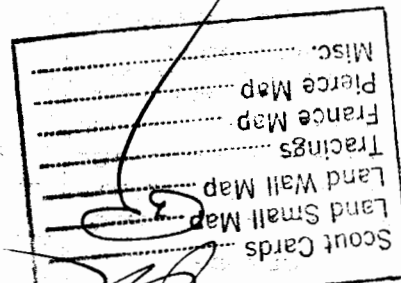

1950 6 MAY

Chase

KANSAS

Sec. 14 Twp. 20 R. 9E ✓

Well No. #1 Piper Farm

Mendenhall Drlg. Company

Contractor

Wildcat


990' Ft. from N. Line

Ft. from S. Line

Ft. from E. Line

330' Ft. from W. Line

SW NW NW

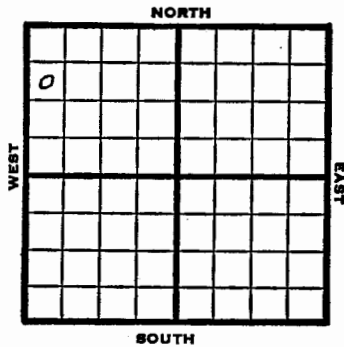

1950 Elev. 1356' REPORT

4/5 8-5/8" @ 65'

WOC

5/31 8-5/8" @ 65'

5" @ 2308'

Heeb 1105'

Burgess 2437'

Lans. 1453'

Miss 2454'

Cherokee 2115'

Bart 2309-49'

DST 2310-2425

Rec. mud NS

D&A TD 2468'

ABANDONED

KANSAS

Chase ✓

Section 14 Township 20 Range 9-E

Well No. #1 Piper

Company Mendenhall Drlg

