


Map No. KANSAS Sec. 1 Twp. 21 R. 1E
Well No. 1 - Leperman Estate Farm
Sun Ray Oil Corp Company

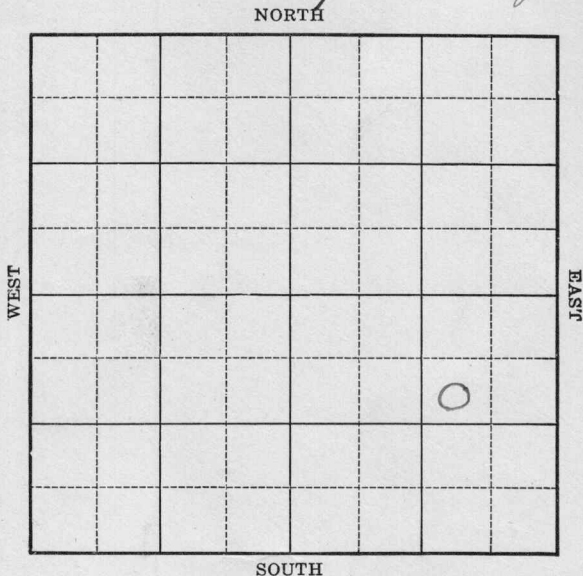

Location _____

Drilling Remarks _____

Rig Up _____

Drilling Remarks _____

RECORD

Cased _____ in. _____ ft.
Sand _____
Gas _____
Oil _____
Total Depth _____

PRODUCTION

1st 24 hrs. Nat. _____
1st 24 hrs. after shot _____
Gas _____ cu. ft.
Dry Hole _____
Abandoned _____

Marion Co.


KANSAS

Map No. Sec. 1 Twp. 21 R. 1E

Well No. 1 - Leberman Est. Farm

Sun Ray Oil Corp Company

NORTH

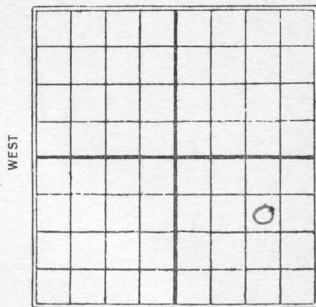

990 Ft. from N. Line

Ft. from S. Line

990 Ft. from E. Line

Ft. from W. Line

1927

Date

REPORT

7/27	R.O.G.
8/3	Rig
8/10	Rigging up
8/17	Spud
8/23	T.D. 150 - straightening bad hole
8/31	Drlg 365 -
9/7	" 782
9/14	" 1250
9/20	" 1700
9/28	" 1985
10/5	T.D. 2030 - S.D.
10/12	—
10/19	—
10/26	—
11/2	T.D. 2030' log pipe
11/9	—
11/16	—
11/22	—
11/29	—
12/7	—
12/14	—
12/21	Set 6" 2192 - drlg 2192 -

12/28 - Drlg 2230-
1928
1/4 - no report
1/11
1/18 - Drlg 2710-
1/25 - " 2735
1/31 - T. D. 2750 - fishing bailer -
2/5 - no report
2/22 - Fishing bailer 2750-
2/29 - Drlg 2795-
3/7 - " 2875
3/14 - Top line 2875 - H.F.W. 2940-50
drilling 2950-
3/21 - no report -
3/28 - Base line 3060 - drlg 3209-
4/4 - no report -
4/11 - Top Sil. line 3281
H.F.W. 3342
T.D. 3342
D. & A.

Marion
 K24 KANSAS MAP No. 1 Sec. 1 TWP 7/5 R. 1E

WELL No. 1 Lehman

Sun Ray Oil COMPANY

CONTRACTOR

*OK with our
 walling*

SECTION PLAT

ABANDONED

_____ FT. FROM N. LINE

_____ FT. FROM S. LINE

_____ FT. FROM E. LINE

_____ FT. FROM W. LINE

RECORD

LOCATION _____

CASED _____ IN. _____ FT.

RIG UP _____

SAND _____

DRILLING AND REMARKS:

GAS _____

OIL _____

TOTAL DEPTH 3342

*3281 } All Limestone
 3342 }
 142 ft.*

PRODUCTION

1ST 24 HRS. NAT. _____

1ST 24 HRS. AFTER SHOT _____

GAS _____ CU. FT.

DRY HOLE ☒

ABANDONED ☒

DATE

4/11 192 8 SCOUT

















*no small
don't cover*

12
100

24 ~~Map No.~~ **KANSAS** Sec. 1 Twp. 21 R. 1E

Well No. 1 Leperman Estate

Sun Ray Oil Corp. Company

Contractor

SECTION PLAT

			0

990 Ft. from N. Line

_____ Ft. from S. Line

990 Ft. from E. Line

_____ Ft. from W. Line

FIRST REPORTS

Location _____

Rig up _____

Drilling and Remarks:

ROG

RECORD

Cased _____ in., _____ ft.

Sand _____

Gas _____

Oil _____

Total Depth _____

PRODUCTION

1st 24 hrs. Nat. _____

1st 24 hrs. after shot _____

Gas _____ Cu. Ft.

Dry Hole _____

Abandoned _____

Date

JUL. 27 1927

192

S. J. LEWIS

Scout





Returned	
Cards	<u>MB</u>
Tracing	
France Map	
Scarborough Map	
Moody Map	
Scarborough Plat Book	
Moody Plat Book	

PRODUCTION

 Map No. **KANSAS** Sec. 1 Twp. 21 R. E

Well No. 1 Scherman Estate

Sun Ray Oil Corp. Company

Contractor

SECTION PLAT

990 Ft. from N. Line

_____ Ft. from S. Line

990 Ft. from E. Line

_____ Ft. from W. Line

			0

ABANDONED

Location _____

Rig up _____

Drilling and Remarks:

Top Soil line

3281

HFW 3342

TJ 3342

J & A

RECORD

Cased _____ in., _____ ft.

Sand _____

Gas _____

Oil _____

Total Depth _____

PRODUCTION

1st 24 hrs. Nat. _____

1st 24 hrs. after shot _____

Gas _____ Cu. Ft.

Dry Hole _____

Abandoned _____

Date

APR 11 1928

S. J. LEWIS Scout

SECTION PLAT

*map of marion Co
wall map*

Returned	
Cards	<i>[Signature]</i>
Tracing	<i>MB</i>
France Map	
Scarborough Map	<i>[Signature]</i>
Moody Map	
Scarborough Plat Book	
Moody Plat Book	