


Map No. KANSAS Sec. 6 Twp. 21 R. 11
 Well No. F Bradford Farm
Gordon-Stooley & Co. Company
 NORTH Empire

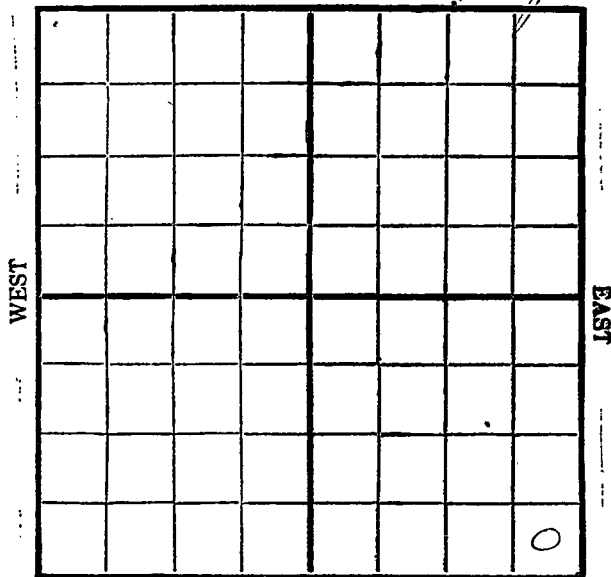

SOUTH

Location _____

Drilling Remarks

Rig Up _____

Drilling Remarks

RECORD

Cased _____ in. _____ ft.

Sand _____

Gas _____

Oil _____

Total Depth _____

PRODUCTION

1st 24 hrs. Nat. _____

1st 24 hrs. after shot _____


Gas _____ cu. ft.

Dry Hole _____

Abandoned _____

Map No. 1-Bradfield Sec. 21 Twp. 11 R. 11 E
Well No. Gordon Hoots - Empire Farm Company

NORTH

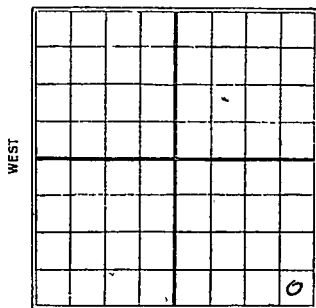

Ft. from N. Line

330 Ft. from S. Line

330 Ft. from E. Line

Ft. from W. Line

1929

Date

REPORT

10/9	Machine
10/16	Spdy.
10/23	dry 545'
10/30	
11/6	set 8"-1600'
11/13	HFW 1968-2030'
	UIR at 2035'
11/20	sand 1968-2030' HFW
	Top line 2085'
	T.D. 2103'
	Dry & Abandon

Lyon

Map No. **KANSAS** Sec. 1 Twp. 21 R. 11^E
 Well No. 21 Bradfield
Gordon-Starts & Empire Company
 Contractor

FIRST REPORTS**SECTION PLAT**

 Ft. from N. Line
330 Ft. from S. Line
330 Ft. from E. Line
 Ft. from W. Line

			0

Location Rig up Machine

Drilling and Remarks:

RECORDCased in., ft.Sand Gas Oil Total Depth **PRODUCTION**1st 24 hrs. Nat. 1st 24 hrs. after shot Gas Cu. Ft.Dry Hole Abandoned

Date

1929

CHAS. L. SHERWOOD

Scout

OCT 9

19

Lyon

Map No. **KANSAS** Sec. 1 Twp. 21 R. 11
 Well No. 1 *Bradfield*
Gordon - Shattuck & Engers Company
 Contractor


COMPLETE

SECTION PLAT

Ft. from N. Line

330 Ft. from S. Line330 Ft. from E. Line

Ft. from W. Line

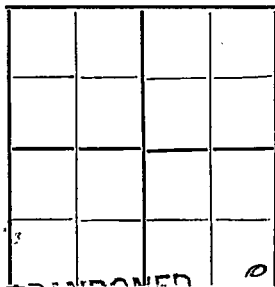

ABANDONED

Location

Rig up

Drilling and Remarks:

Top line 7085

RECORD

Cased _____ in., _____ ft.

Sand 1968-7030 *NEW*

Gas _____

Oil _____

Total Depth 2103

PRODUCTION

1st 24 hrs. Nat. _____

1st 24 hrs. after shot _____

Gas _____ Cu. Ft.

Dry Hole ☒Abandoned ☒

Date

NOV 20 1929
192CHAS. L. SHERWOOD
Scout