

FORM 51

Lyon

KANSAS ✓

Section 19 Township 21 Range 10EWell No. #1-B Pearl LoweCompany Stewart Oil Company

NORTH

				D			

SOUTH

WEST EAST

Lyon

KANSAS ✓

19

21

10^E

Sec. _____ Twp. _____ R. _____

Well No. #1-B Pearl Lowe Farm _____

Stewart Oil

Company _____

White & Ellis

Contractor _____

_____ Ft. from N. Line

330


_____ Ft. from S. Line

_____ Ft. from E. Line

330

_____ Ft. from W. Line

SW SW NE

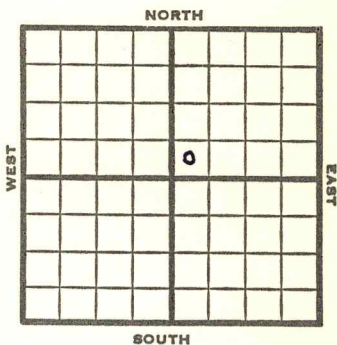

1953

Elev. -

REPORT

2/4

Spud 1-30-53

8" @ 100

Drlg. 1456'

2/18

Spud 1-30-53 Oil well TD 2229

8" @ 100 **Lans 1292 KC 1584****Bart 2200** TD 2229 5" @ 2229

16/2194-98 12/2200-03 12/2212-15

6 BOPH 8 hr.

Comp. 50 BOPD

COMPLETED

County Lyon State Kansas

Sec. 19 (Blk. Twp.) 21 (Sur. Rge.) 10E Map No.

Operator Stewart Oil

Well No. 1-B Farm Pearl Lowe

Elev.	Location	SW	SW	NE
-------	----------	----	----	----

330 Ft. From S Line NE

330 Ft. From W Line Quarter

1st. Report

Completion FEB 18 1953

Remarks

White & Ellis - Contr.

Spudding Date 1-30-53

Drlg. Data Oil well TD 2229

8" @ 100 Lans. 1292 KC 1584

Bart. 2200 TD 2229 5" @ 2229

16/ 2194-98 12/ 2200-03 12/ 2212-15

6 boph 8 hr. Comp. 50 bopd

J. G. McGEHEE

~~Lyon~~

5. 2. 1825

(Blk.)
(Twp.)

(Sur.)
(Rge.)

10E

Map No.

Stewart Oil

1-B Farm Pearl Lowe

Location	SW	SW	NE
----------	----	----	----

0

FIRST REPORT

330 Ft. From S Line NE

330	Ft. From	W	Line	Quarter
-----	----------	---	------	---------

1st. Report FEB 4 1953

Completion

Remarks

~~White & Ellis - Contr.~~

Spudding Date 1-30-53

Drlg. Data

8" @ 100 drlg. 1456

J. G. McGEHEE

1950-1951