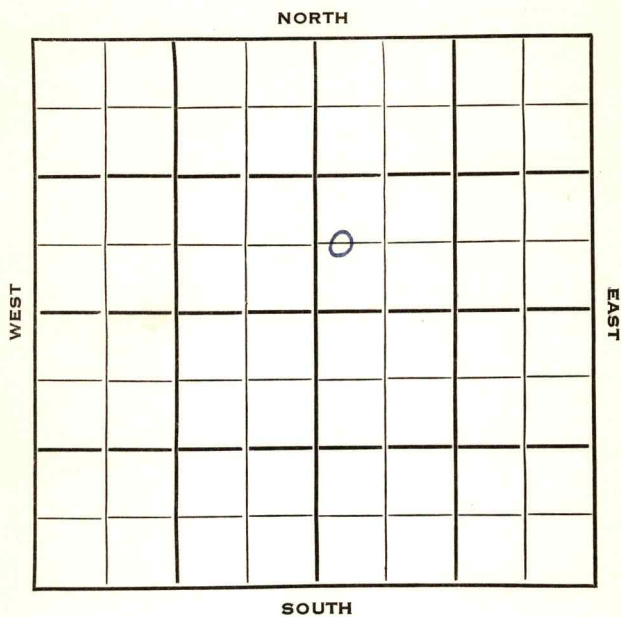


Lyon

KANSAS

Section 19 Township 21 Range 10EWell No. #3 Lowe "B"Company Stewart Oil

Lyon

KANSAS

Sec. 19 Twp. 21 R. 10 EWell No. # 3 Lowe "B" FarmStewart Oil

Company

White & Ellis

Contractor

Ft. from N. Line

660


Ft. from S. Line

Ft. from E. Line

330

Ft. from W. Line

C W L SW NE

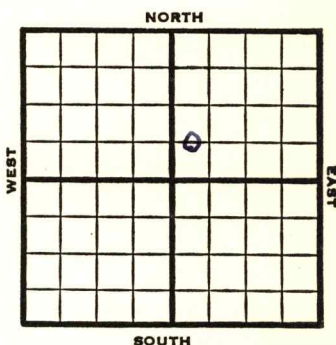

1953

Elev. -

REPORT

5/6

Spud 5-1-53

8" @ 105 **Lans 1240**

Drlg. 1245'

6/10

Spud 5-1-53 Oil well TD 2260

8" @ 105 **Lans 1240 B. Lans. 1386****KC 1464 Bart 2171 Bart sd. 2204**

TD 2260 5" @ 2260 20/2204-08

20/2206-10 6 BOPD st-frac.

S/3 $\frac{1}{2}$ BOPH

Comp. 27 BOPD

COMPLETED

Operator **Stewart Oil**

Well No. **3** Farm **Lowe "B"**

[illegible]

0

FIRST REPORT

660 Ft. From S Line NE

330 Ft. From W Line Quarter

1st. Report MAY 6 1953

Completion


Remarks

White & Ellis - Contr.

Spudding Date 5-1-53

Drig. Data

8" @ 105 Lans. 1240 drlg. 1245

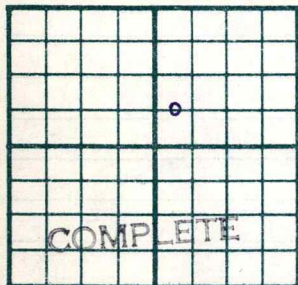County Lyon State KansasSec. 19 (Blk. 21 (Sur. 10E Map No. 10E) (Twp. 21 (Rge. 10E)Operator Stewart OilWell No. 3 Farm Lowe "B"Elev. Location C W L SW NE660 Ft. From S Line NE330 Ft. From W Line Quarter1st. Report Completion JUN 10 1953Remarks White & Ellis - Cmtr.Spudding Date 5-1-53Drig. Data Oil well TD 22608" @ 105 Lans. 1240 B. Lans. 1386KC 1464 Bart. 2171 Bart. sd. 2204TD 2260 5" @ 2260 20/ 2204-0820/ 2206-10 6 bopd st-fracS/ 3½ boph Comp. 27 bopd

J. G. McGEHEE