

KANSAS

Lyon


Section 19 Township 21 Range 10E

Well No. 3 Jones

Company Sheedy

Misc.

NORTH

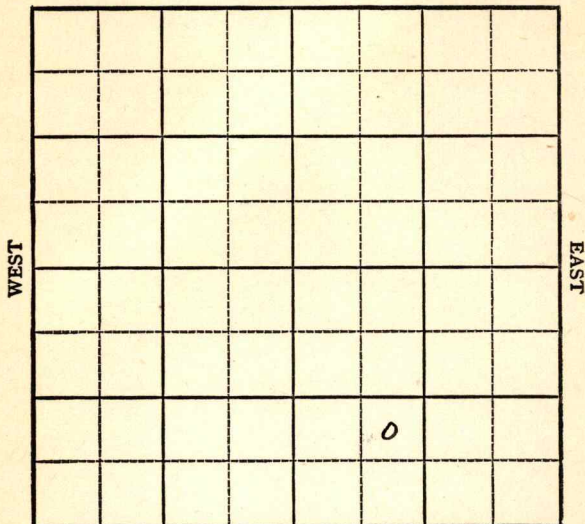

SOUTH

KANSAS Lyon

Sec. 19 Twp. 21 R. 10E ✓

Well No. 3 Jones Farm

Sheedy Company

Misc.


 Ft. from N. Line

990 Ft. from S. Line

 Ft. from E. Line

990 Ft. from W. Line

NE SW SE

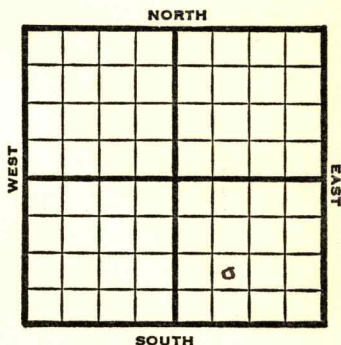

R E P O R T

1948

11/17 7" @ 2130'
Drlg. 2160'

11/23 "

11/30 "

12/6 "

12/15 TD 2282'

Sand 2126'

Aband.

ABANDONED

Map No. 21 Sec. 19 Twp. 21 R. 10EWell No. 3 JonesSheedy et al.

Company

ABANDONED

Contractor

NE SW SE

SECTION PLAT

		0	

 Ft. from N. Line990 Ft. from S. Line Ft. from E. Line990 Ft. from W. LineLyon CountyLocation Rig up

Drilling and Remarks:

Land 2/26

RECORD

Cased in., ft.Sand Gas Oil Total Depth 2282

PRODUCTION

1st 24 hrs. Nat. 1st 24 hrs. after shot Gas Cu. Ft.Dry Hole Abandoned

Date

DEC 15 194819S. J. LEWISScout

Map No. _____ Sec. 19 Twp. 21 R. 10E

Well No. 3 Jones

Sheedy Company

FIRST REPORT

Contractor

NE SW SE

SECTION PLAT

_____ Ft. from N. Line

990 Ft. from S. Line

_____ Ft. from E. Line

990 Ft. from W. Line

Lyon County

Location _____

Rig up _____

Drilling and Remarks:

7" @ 2130

drlg. 2160

RECORD

Cased _____ in., _____ ft.

Sand _____

Gas _____

Oil _____

Total Depth _____

PRODUCTION

1st 24 hrs. Nat. _____

1st 24 hrs. after shot _____

Gas _____ Cu. Ft.

Dry Hole _____

Abandoned _____

Date

NOV 17 1948

19

S. J. LEWIS

Scout