


Map No. KANSAS Sec. 19 Twp. 21 R. 10^E

Well No. 5 - Hughes Farm _____

Shedy et al Company _____

NORTH

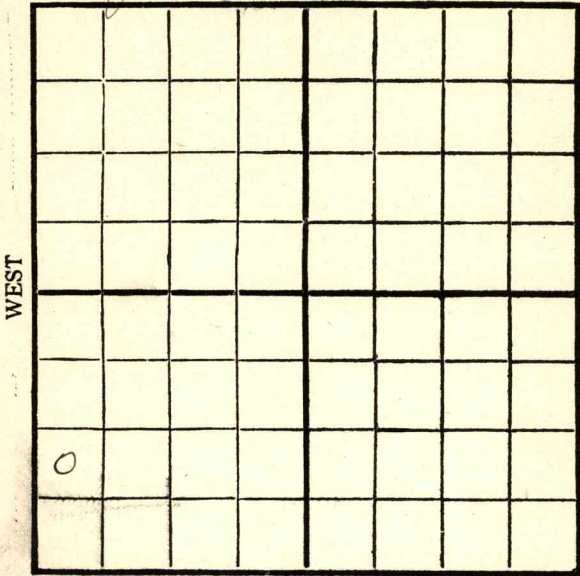

SOUTH

Location _____

Drilling Remarks _____

Rig Up _____

Drilling Remarks _____

RECORD

Cased _____ in. _____ ft.

Sand _____

Gas _____

Oil _____

Total Depth _____

PRODUCTION

1st 24 hrs. Nat. _____

1st 24 hrs. after shot _____

Gas _____ cu. ft. _____

Dry Hole _____

Abandoned _____

Map No. KANSAS Sec. 19 Twp. 21 R. 10^E

Well No. 5 - Hughes Farm


Sheedy et al Company

_____ Ft. from N. Line

990 Ft. from S. Line

_____ Ft. from E. Line

330 Ft. from W. Line

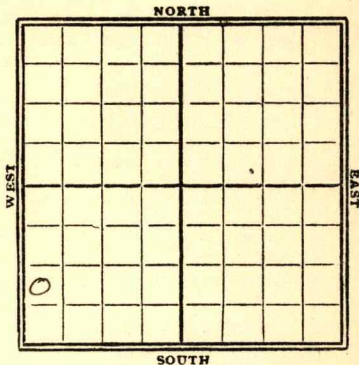

1929

Date	REPORT
12/4	Run up
12/11	Dry 600'
12/23	" 1600'
12/30	" 2250'
1930	
1/8	No report
1/15	—
1/22	—
1/29	—
2/4	—
2/12	T.D. 2340
	P.B. to 2215'
	Sand 2195'-2215'
	shot 40 qt
	15 bbls oil
	Comp.

lyon

Map No. 21 **KANSAS** Sec. 19 Twp. 21 R. 10 E

Well No. 5 *Hughes*

Sheedy et al Company

Contractor

FIRST REPORTS

SECTION PLAT

..... Ft. from N. Line
990 Ft. from S. Line
..... Ft. from E. Line
330 Ft. from W. Line

0			

Location.....
Rig up.....
Drilling and Remarks:

Rigging up

RECORD

Cased..... in., ft.
Sand.....
Gas.....
Oil.....
Total Depth.....

PRODUCTION

1st 24 hrs. Nat.....
1st 24 hrs. after shot.....
Gas..... Cu. Ft.
Dry Hole.....
Abandoned.....

Date
DEC 4 1929

CHAS. L. SHERWOOD

..... 192..... Scout

Hyon

Map No. **KANSAS** Sec. *19* Twp. *21* R. *10*

Well No. *21 5 Hughes*

Sheedy Company

..... Contractor

COMPLETE

SECTION PLAT

..... Ft. from N. Line

990 Ft. from S. Line

..... Ft. from E. Line

330 Ft. from W. Line

<i>0</i>			

Location.....

Rig up.....

Drilling and Remarks:

PBto 2215

40/15 Bls

RECORD

Cased..... in., ft.

Sand *2195-2215*

Gas.....

Oil.....

Total Depth *2340*

PRODUCTION

1st 24 hrs. Nat.....

1st 24 hrs. after shot.....

Gas..... Cu. Ft.

Dry Hole.....

Abandoned.....

Date

FEB 12 1930

CHAS. L. SHERWOOD

..... 192.....

..... Scout