


Map No. 19 Sec. 21 Twp. 10<sup>E</sup>

Well No. 4 - Hughes Farm  
Sheedy et al Company

NORTH

WEST

EAST

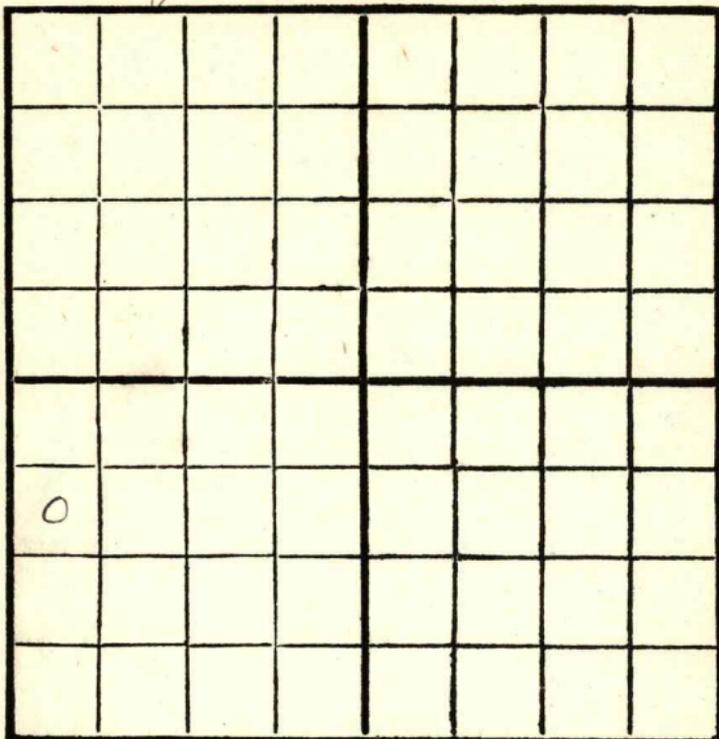

SOUTH

Location \_\_\_\_\_  
Drilling Remarks \_\_\_\_\_

Rig Up \_\_\_\_\_  
Drilling Remarks \_\_\_\_\_

\_\_\_\_\_  
\_\_\_\_\_  
RECORD

PRODUCTION


Cased \_\_\_\_\_ in. \_\_\_\_\_ ft.  
Sand \_\_\_\_\_  
Gas \_\_\_\_\_  
Oil \_\_\_\_\_  
Total Depth \_\_\_\_\_

1st 24 hrs. Nat. \_\_\_\_\_  
1st 24 hrs. after shot \_\_\_\_\_  
Gas \_\_\_\_\_ cu. ft. \_\_\_\_\_  
Dry Hole \_\_\_\_\_  
Abandoned \_\_\_\_\_

Map No. **KANSAS** Sec. 19 Twp. 21 R. 10<sup>E</sup>

Well No. 4 - Hughes Farm  
Shedy et al Company

990 Ft. from N. Line  
 \_\_\_\_\_ Ft. from S. Line  
 \_\_\_\_\_ Ft. from E. Line  
330 Ft. from W. Line

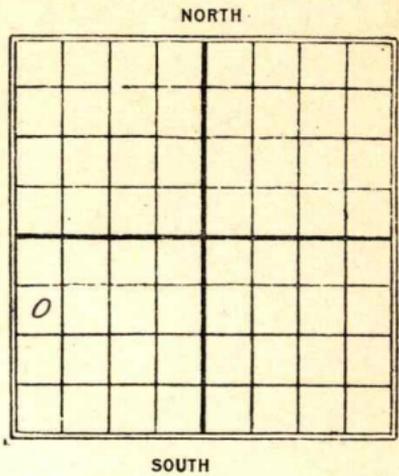

1929

Date	REPORT
10/2	Bdy Reg
10/19	Wgn up
10/16	J
10/23	Spdy 200'
10/30	Drly 900'
11/6	" 1450'
11/13	" 1675'
11/20	Sand 2197-2244'
	TD. 2244'
	P.B. to 2238'
	Pay 2157-87'
	shot 60 gts
	200 bbls oil
	Comp.

*Lyon*

*21* **KANSAS**

Map No. \_\_\_\_\_ Sec. *19* Twp. *21* R. *10<sup>E</sup>*

Well No. *4 Hughes*

*Sheedy et al* Company

Contractor

**FIRST REPORTS**

*990* Ft. from N. Line

\_\_\_\_\_ Ft. from S. Line

\_\_\_\_\_ Ft. from E. Line

*330* Ft. from W. Line

**SECTION PLAT**

<i>0</i>			

Location \_\_\_\_\_

Rig up *Blag Rig*

Drilling and Remarks: \_\_\_\_\_

**RECORD**

Cased \_\_\_\_\_ in., \_\_\_\_\_ ft.

Sand \_\_\_\_\_

Gas \_\_\_\_\_

Oil \_\_\_\_\_

Total Depth \_\_\_\_\_

**PRODUCTION**

1st 24 hrs. Nat. \_\_\_\_\_

1st 24 hrs. after shot \_\_\_\_\_

Gas \_\_\_\_\_ Cu. Ft.

Dry Hole \_\_\_\_\_

Abandoned \_\_\_\_\_

Date

**OCT 2 1929**

**CHAS. L. SHERWOOD**

19

Scout

Map No. **KANSAS** Sec. *19* Twp. *71* R. *10*

Well No. *4* *Sheedy* *Hughes* *et al*

Company

Contractor

**COMPLETE**

**SECTION PLAT**

*990* Ft. from N. Line

..... Ft. from S. Line

..... Ft. from E. Line

*330* Ft. from W. Line


Location.....

Rig up.....

Drilling and Remarks:

*Sand 2197-2244*

*PB to 2238*

*60/200 PB*

**RECORD**

Cased..... in., ..... ft.

Sand *2157-2187*

Gas.....

Oil.....

Total Depth *2244*

**PRODUCTION**

1st 24 hrs. Nat.....

1st 24 hrs. after shot.....

Gas..... Cu. Ft.

Dry Hole.....

Abandoned.....

Date

**NOV 20 1929**

192.....

**CHAS. L. SHERWOOD**

Scout