FORM 51 10M 7-48 PETROL


KANSAS Marion

Section 10 Township 21 Range 3E

Well No. 2 Ebright "A"

Company Branine & Goering

Wenger Pool

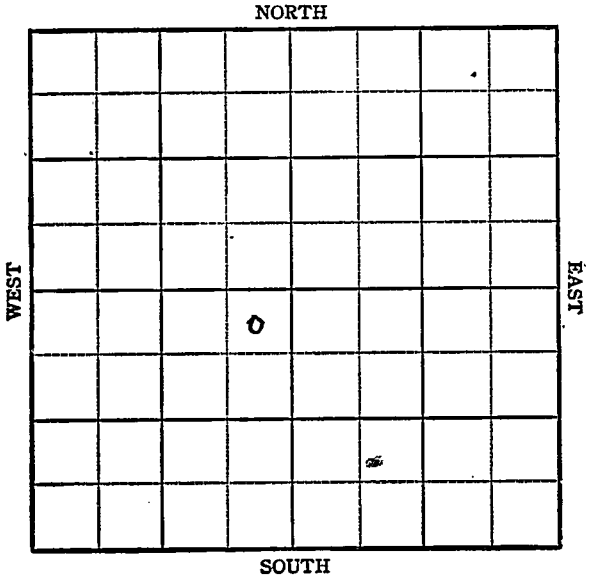

FORM 252-A
5M 10-48 PETROL

KANSAS Marion

Sec. 10 Twp. 21 R. 3E ✓

Well No. #2 Ebright "A" Farm

Branine & Goering Company

Wenger Pool


330' Ft. from N. Line

Ft. from S. Line

330' Ft. from E. Line

Ft. from W. Line

NE SW

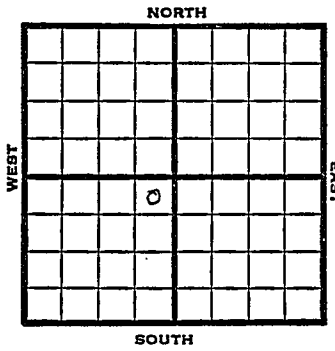

1948	REPORT
12/29	Location
1/5	8" @ 105' Drlg. 1000'
1/12	KC 1919 Wisener 2788 Hunton 2789-90 TD 4" @ 2790
1/19	"
1/27	Base Hunton 2797' TD 2804
2/2	2000' oil 12 hrs. TD 2804' Hunton 2789' 4"@ 2790' 2000 acid Pump 35 Oil Pot 38° Gr. Comp **COMPLETED**

Form 26 200 Bks. 9-48 Petrol

Kansas

Wenger Pool

Map No. ____ Sec. 10 Twp. 21 R. 3E

Well No. 2 Ebright "A"

Branine & Goering Company

FIRST REPORT Contractor

NE SW


330 Ft. from N. Line

____ Ft. from S. Line

330 Ft. from E. Line

____ Ft. from W. Line

SECTION PLAT

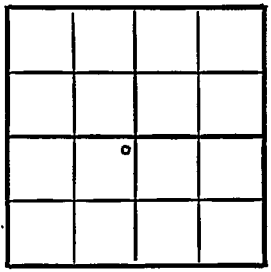

Marion County

Location x

Rig up

Drilling and Remarks:

RECORD

Cased ____ in., ____ ft.

Sand

Gas

Oil

Total Depth

PRODUCTION

1st 24 hrs. Nat.

1st 24 hrs. after shot

Gas ____ Cu. Ft.

Dry Hole

Abandoned

Date

DEC 29 1948 19

S. J. LEWIS Scout

Form 26 200 Bks. 9-48 Petrol

Kansas

Wenger Pool

Map No. 24 Sec. 10 Twp. 21 R. 3E

Well No. 2 Ebright "A"

Branine & Goering Company

COMPLETE Contractor

NE SW


330 Ft. from N. Line

____ Ft. from S. Line

330 Ft. from E. Line

____ Ft. from W. Line

SECTION PLAT

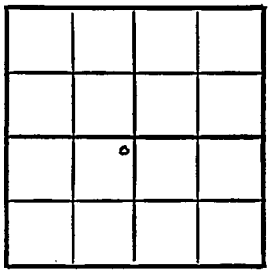

Marion County

Location ____

Rig up ____

Drilling and Remarks:

Hun tbg 2787

4" @ 2790

2000 acid

Pump & sail Pot

38° Gr

RECORD

Cased ____ in., ____ ft.

Sand ____

Gas ____

Oil ____

Total Depth 2804

PRODUCTION

1st 24 hrs. Nat. ____

1st 24 hrs. after shot ____

Gas ____ Cu. Ft.

Dry Hole ____

Abandoned ____

Date

FEB 2 1949 19

S. J. LEWIS Scout