



Sec. 10 Twp. 21 R. 3E

Well No. #3 Ebright Farm

Mendenhall Drilling Company

Mendenhall Contr. Contractor


\_\_\_\_\_ Ft. from N. Line

990' Ft. from S. Line

990' Ft. from E. Line

\_\_\_\_\_ Ft. from W. Line

NW SE SW

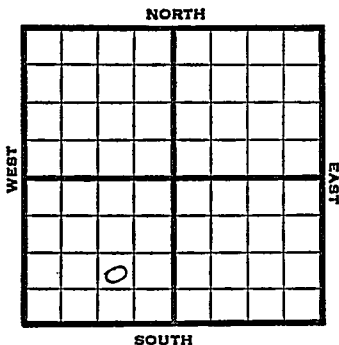

1951

Elev. 1404' REPORT

7/11

8-5/8" @ 75'

8/8

Spud 7-6-51

Oil well TD 2802' 8-5/8" @ 75'

Miss. 2494' Kh 2641' Misenor 2797'

Hunton 2798-2802' 4 1/2" @ 2798'

TD 2802' 1000 A

Comp. 30 BOPD 5% water

**COMPLETED**



