

Section 10 Township 21 Range 3E

Well No. 1 Ebright

Company Branine & Goering

Wenger Pool

NORTH

WEST

EAST

			0				

SOUTH

Sec. 10 Twp. 21 R. 3-E

Well No. #1 Ebright Farm

Branine & Goering Company
Wegber


990 Ft. from N. Line

_____ Ft. from S. Line

330 Ft. from E. Line

_____ Ft. from W. Line

SE NE SW

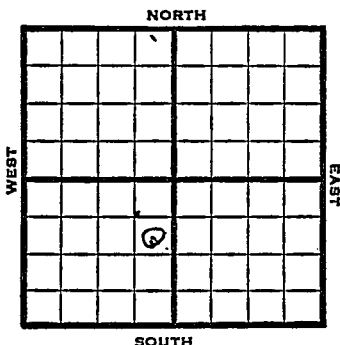

1948

Elev. 1408'

REPORT

9/29

RUR

10/6

8" @ 100'
Drlg. 1892'

10/13

Miss 2485'
Hunton 2797'
TD 2801'
5" @ 2798'

10/19

300' oil & 2100' W
PB

10/26

"

11/3

"

11/10

"

11/17

Hunton 2797'
5" @ 2798'
Pump 20 oil & 60 W Pot.
Gr.39
TD 2801

COMPLETED

Map No. _____ Sec. 10 Twp. 21 R. 3E

Well No. 1 Ebright

Branine & Goering. Company

FIRST REPORT Contractor

SE NE SW


SECTION PLAT

990 Ft. from N. Line

_____ Ft. from S. Line

330 Ft. from E. Line

_____ Ft. from W. Line

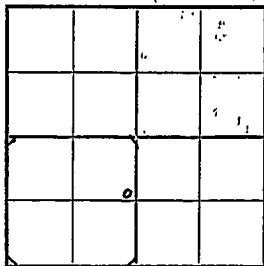

Marion County

RECORD

Location _____

Cased _____ in., _____ ft.

Rig up _____

Sand _____

Drilling and Remarks:

Gas _____

Oil _____

R U R

Total Depth _____

PRODUCTION

1st 24 hrs. Nat. _____

1st 24 hrs. after shot _____

Gas _____ Cu. Ft.

Dry Hole _____

Abandoned _____

Date

SEP 29 1948 19

S. J. LEWIS Scout

Map No. 2A Sec. 10 Twp. 21 R. 3E

Well No. 1 Ebright

Branine & Goering Company

COMPLETE Contractor

SE NE SW

E. 11407

SECTION PLAT

990 Ft. from N. Line

 Ft. from S. Line

330 Ft. from E. Line

 Ft. from W. Line

Marion County

Location

Rig up

Drilling and Remarks:

Hunter 2797

5" @ 2798

Run 200 oil + 6W

PD

89° E

RECORD

Cased in., ft.

Sand

Gas

Oil

Total Depth 2801

PRODUCTION

1st 24 hrs. Nat.

1st 24 hrs. after shot

Gas Cu. Ft.

Dry Hole

Abandoned

Date

NOV 17 1948 19

S. J. LEWIS

Scout