


Section 10 Township 21 Range 3E

Well No. #1 Ford

Company Branine & Goering et al
Wenger Pool

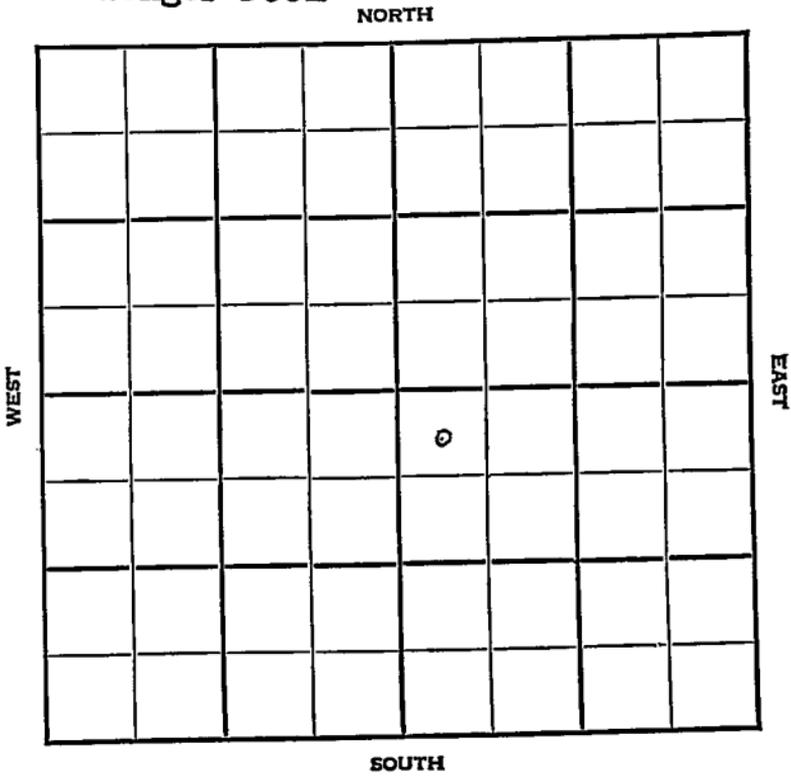

KANSAS

Marion

Sec. 10 Twp. 21 R. 3E

Well No. #1 Ford Farm

Branine & Goering et al Company

Wenger Pool


330' Ft. from N. Line

_____ Ft. from S. Line

_____ Ft. from E. Line

330' Ft. from W. Line

NW SE

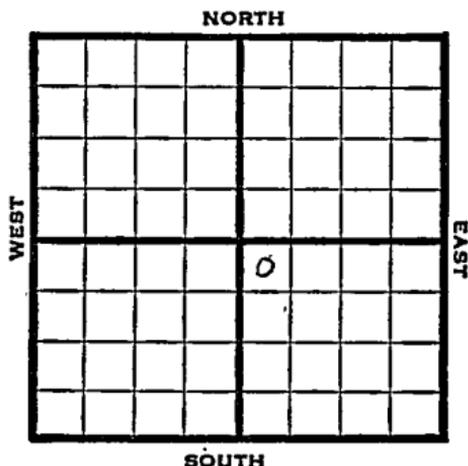

1948

Elev. 1394' REPORT

3/24

Location

3/31

8" @ 68'
Drlg. 1160'

4/7

Lansing 1915'
Miss. 2483'
Drlg. 2488'

4/14

Fsg. 2545'

4/21

"

4/28

Drlg. 2570'

5/5

Hunton 2789'
TD 2794'
5" @ 2789'
RUST

5/12

"

5/19

"

5/26

Hunton 2789'
5" @ 2789'
4000 Acid
Pump 15 oil Pot.
Gr. 39°
TD 2802'

COMPLETED

Map No. _____ Sec. 10 Twp. 21 R. 3E

Well No. 1 Ford

Branine & Goering etal. Company

FIRST REPORT Contractor

NW SE


SECTION PLAT

330 Ft. from N. Line

_____ Ft. from S. Line

_____ Ft. from E. Line

330 Ft. from W. Line

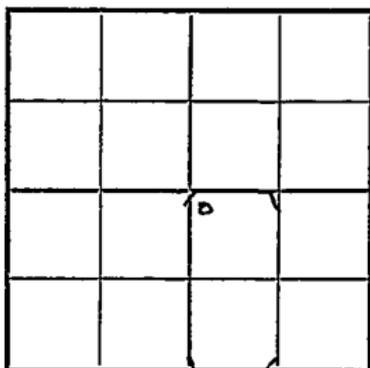

Marion County

RECORD

Location X

Rig up _____

Drilling and Remarks:

Cased _____ in., _____ ft.

Sand _____

Gas _____

Oil _____

Total Depth _____

PRODUCTION

1st 24 hrs. Nat. _____

1st 24 hrs. after shot _____

Gas _____ Cu. Ft.

Dry Hole _____

Abandoned _____

Date

MAR 24 1948 19

S. J. LEWIS Scout

Map No. 2A Sec. 10 Twp. 21 R. 3E

Well No. 1 Ford

Branine & Goering etal. Company

COMPLETE

Contractor

NW SE

E. 1394

SECTION PLAT

330 Ft. from N. Line

_____ Ft. from S. Line

_____ Ft. from E. Line

330 Ft. from W. Line

		α	

Mariion County

Location _____

Rig up _____

Drilling and Remarks:

Hunter 2789
5" @ 2789
4000 rods
Pump Oil Rod
89 = 4

RECORD

Cased _____ in., _____ ft.

Sand _____

Gas _____

Oil ✓

Total Depth 2802

PRODUCTION

1st 24 hrs. Nat. _____

1st 24 hrs. after shot _____

Gas _____ Cu. Ft.

Dry Hole _____

Abandoned _____

Date

MAY 26 1948

19

S. I. LEWIS Scout