


Section 10 Township 21 Range 3E

Well No. 3 Ford

Company Branine & Goering

Wenger

NORTH

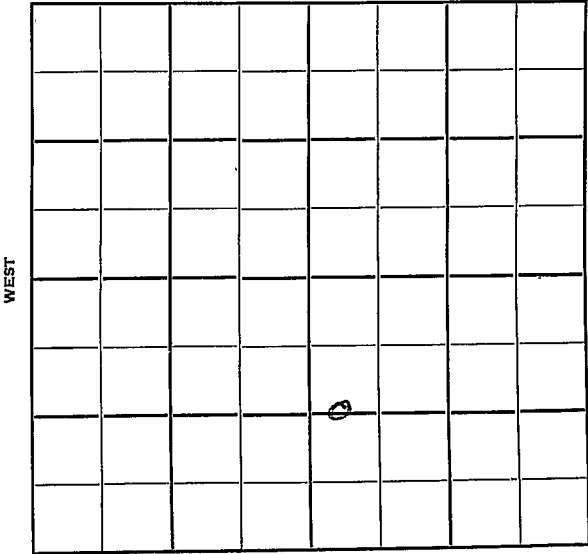

SOUTH

Marion **KANSAS**

Sec. 10 Twp. 21 R. 3E ✓

Well No. #3 Ford Farm
Branine & Goering Company


Wenger Pool (Mendenhall, Contour)

1320' Ft. from N. Line

_____ Ft. from S. Line

_____ Ft. from E. Line

330' Ft. from W. Line

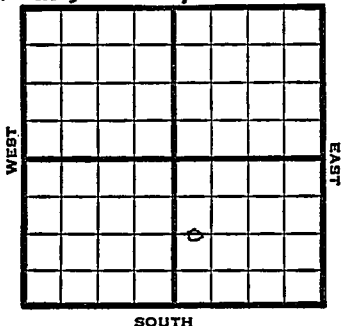

C $W\frac{1}{2}$ $W\frac{1}{2}$ SE

1949

lev 1406'

REPORT

- 6/8 8" @ 92'
Drlg. 1137'
- 6/15 2608 fsg.
- 6/21 "
- 6/28 Hunton 2795'
5" @ 2795'
TD 2800' - 2000 acid
TD 2800'
- 7/6 Hunton 2795'
5 @ 2795'
Pump 3 Oil / W Pot
38° Gr.
Comp

COMPLETED

Marion County Kansas State

Map No. _____ Sec. 10 Twp. 21 R. 3E

Well No. 3 Ford

Branine & Goering Company

Mendenhall Contractor

C $W\frac{1}{2}$ $W\frac{1}{2}$ SE

**FIRST REPORT
SECTION PLAT**

1320 Ft. from N. Line

_____ Ft. from S. Line

_____ Ft. from E. Line

330 Ft. from W. Line

Wenger Pool

Remarks:

8" @ 92 drlg. 1137

Date JUN '8 1949

Scout S. J. LEWIS

Map No. K24 Sec. 10 Twp. 21 R. 3E

Well No. 3 Ford

Branine & Goering Company

COMPLETE

Contractor

C $W\frac{1}{2}$ $W\frac{1}{2}$ Se

E. 1406
SECTION PLAT

1320 Ft. from N. Line

_____ Ft. from S. Line

_____ Ft. from E. Line

330 Ft. from W. Line

Marion County

Location _____

Rig up _____

Drilling and Remarks:

Hunter 2795
5" @ 2795
Puny soil + W.
BT
38-6

RECORD

Cased _____ in., _____ ft.

Sand _____

Gas _____

Oil _____

Total Depth 2880

PRODUCTION

1st 24 hrs. Nat. _____

1st 24 hrs. after shot _____

Gas _____ Cu. Ft.

Dry Hole _____

Abandoned _____

Date

JUL 6th 1941

S. J. LEWIS Scout