


Section 10 Township 21 Range 3E

Well No. 4 Mott

Company Branine & Goering
Wenger Pool

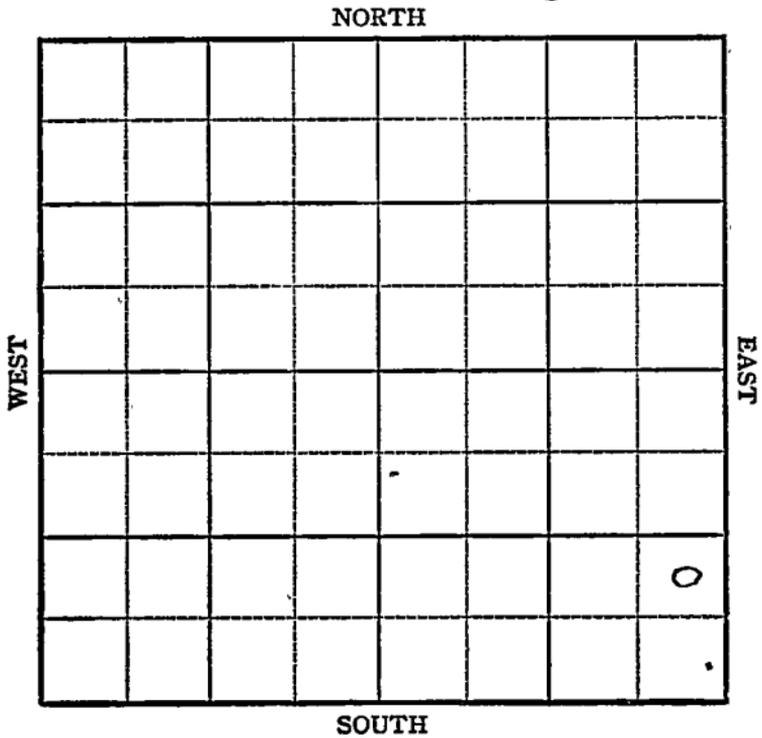



Sec. 10 Twp. 21 R. 3E

Well No. #4 Mott Farm

Branine & Goering Company


Wenger Pool

_____ Ft. from N. Line

990' Ft. from S. Line

330' Ft. from E. Line

_____ Ft. from W. Line

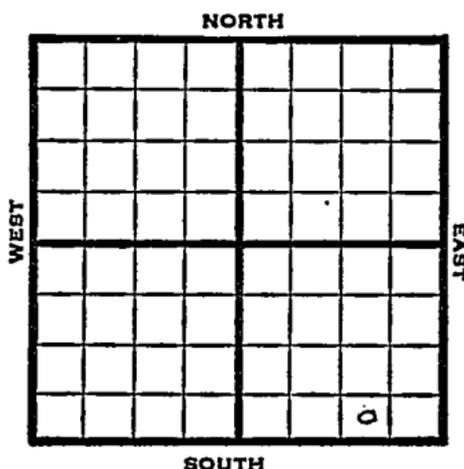

NE SE SE

1948

Eli 1389'

REPORT

10/20

Location

10/26

RUR

11/3

8" @ 75'

Drlg 2654'

11/10

Miss. 2475'

Hunton 2782-83'

TD 2783'

4" @ 2782'

11/16

"

11/23

"

11/30

"

12/6

"

12/15

TD 2790'

Hunton 2782'

4" @ 2782'

Pump 25 Oil Pot

36° Gr.

Comp

COMPLETED

Map No. _____ Sec. 10 Twp. 21 R. 3E

Well No. 4 Mott

Branine & Goering Company

FIRST REPORT Contractor

NE SE SE

SECTION PLAT

_____ Ft. from N. Line

990 Ft. from S. Line

330 Ft. from E. Line

_____ Ft. from W. Line

			6

Marion County

RECORD

Location X

Cased _____ in., _____ ft.

Rig up _____

Sand _____

Drilling and Remarks:

Gas _____

Oil _____

Total Depth _____

PRODUCTION

1st 24 hrs. Nat. _____

1st 24 hrs. after shot: _____

Gas _____ Cu. Ft.

Dry Hole _____

Abandoned _____

Date

OCT 20 1948

S. J. LEWIS Scout

