

Section 10 Township 21 Range 3EWell No. #2 FordCompany Branine & Goering
Wenger

					0		

NORTH

WEST

EAST

SOUTH

KANSAS

Marion

Sec. 10 Twp. 21 R. 3-E

Well No. #2 Ford Farm

Branine & Goering

Company


Wenger Pool

990 Ft. from N. Line

 Ft. from S. Line

 Ft. from E. Line

990 Ft. from W. Line

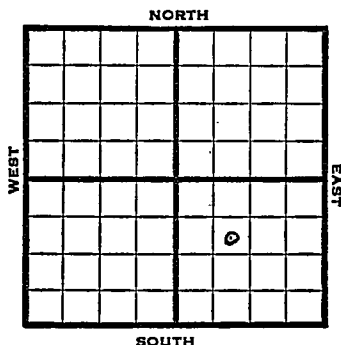

SE NW SE

1948

Elev. 1406' REPORT

10/13

RUR

10/19

8" @ 72'

Drlg. 2006'

10/26

Miss 2485'

Hunton 2798'

TD 2801'

SO

4" @ 2791'

11/3

Hunton 2798'


TD 2801'

ABANDONED

Map No. _____ Sec. 10 Twp. 21 R. 3EWell No. 2 FordBranine & Goering CompanyFIRST REPORT Contractor

SE NW SE

SECTION PLAT

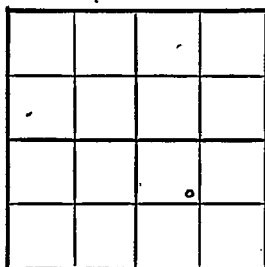990 Ft. from N. Line Ft. from S. Line Ft. from E. Line990 Ft. from W. LineMarion County

Location _____

Rig up _____

Drilling and Remarks:

R U R

RECORD

Cased _____ in., _____ ft.

Sand _____

Gas _____

Oil _____

Total Depth _____

PRODUCTION

1st 24 hrs. Nat. _____

1st 24 hrs. after shot _____

Gas _____ Cu. Ft.

Dry Hole _____

Abandoned _____

Date

OCT 13 1948 19S I LEWIS Scout

Map No. 24 Sec. 10 Twp. 21 R. 3E

Well No. 2 Ford

Branine & Goering Company

ABANDONED

Contractor

SE NW SE


E. 1406
SECTION PLAT

990 Ft. from N. Line

 Ft. from S. Line

 Ft. from E. Line

990 Ft. from W. Line

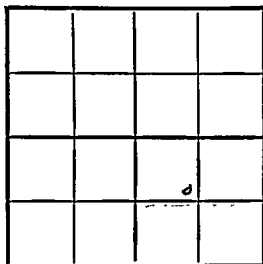

Marion County

RECORD

Location

Rig up

Drilling and Remarks:

Hun Ton 2798

Cased in., ft.

Sand

Gas

Oil

Total Depth 2801

PRODUCTION

1st 24 hrs. Nat.

1st 24 hrs. after shot

Gas Cu. Ft.

Dry Hole

Abandoned

Date

NOV 3 1948 19

S. J. LEWIS Scout