FORM 51 10M 8-47

KANSAS


Marion

Section 10 Township 21 Range 3-E

Well No. #2 Mott

Company Branine & Goering etal

Wenger Pool

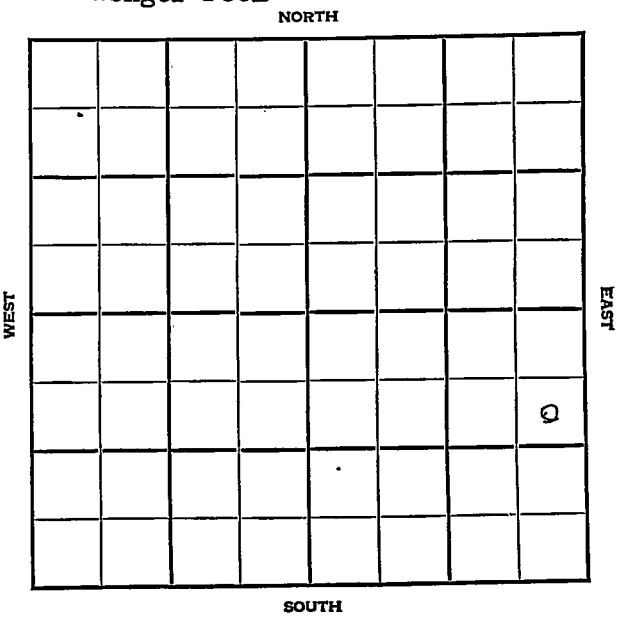

FORM 252-A
5M 4-48 PETROL

KANSAS

Marion ✓

Sec. 10 Twp. 21 R. 3E

Well No. #2 Mott Farm

Branine & Goering et al Company

Wenger Pool


990' Ft. from N. Line

_____ Ft. from S. Line

330' Ft. from E. Line

_____ Ft. from W. Line

SE NE SE

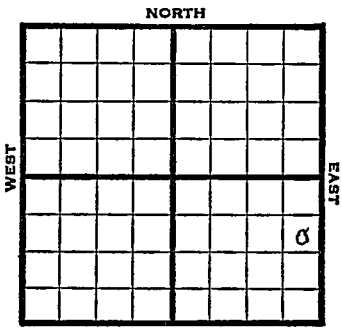

1948	REPORT
	Elev. 1388'
5/26	RUR
6/1	8" @ 60' Drlg. 2156'
6/9	"
6/16	TD 2783' Hunton 2778' 5"@ 2779' Pump 40 Oil Pot 38° Gr. Compl COMPLETED

Form 26—200 Bks.—1-48—Palace

Kansas

Wenger Pool

Map No. _____ Sec. 10 Twp. 21 R. 3E

Well No. 2 Mott

Branine & Goering etal. Company

FIRST REPORT

Contractor

SE NE SE


990 Ft. from N. Line

_____ Ft. from S. Line

330 Ft. from E. Line

_____ Ft. from W. Line

SECTION PLAT

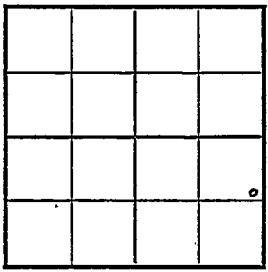

Marion County

Location _____

Rig up _____

Drilling and Remarks:

R U R

RECORD

Cased _____ in., _____ ft.

Sand _____

Gas _____

Oil _____

Total Depth _____

PRODUCTION

1st 24 hrs. Nat. _____

1st 24 hrs. after shot _____

Gas _____ Cu. Ft.

Dry Hole _____

Abandoned _____

Date

MAY 26 1948 19____

S. J. LEWIS Scout

Form 26—200 Bks.—1-48—Palace

Wenger Pool

Kansas

Map No. 24 Sec. 10 Twp. 21 R. 3E

Well No. 2 Mott


Branine & Goering Company

COMPLETE Contractor

SE NE SE

El. 1388.

SECTION PLAT

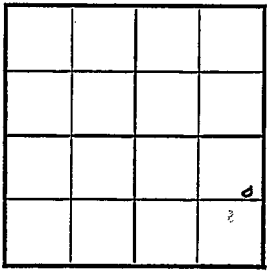

990 Ft. from N. Line

Ft. from S. Line

330 Ft. from E. Line

Ft. from W. Line

Marion County

Location

Rig up

Drilling and Remarks:

Hunton 2778

5" @ 2779

Pump 40 & 10 bbl

352 Gas

RECORD

Cased in., ft.

Sand

Gas

Oil ✓

Total Depth 2783

PRODUCTION

1st 24 hrs. Nat.

1st 24 hrs. after shot

Gas Cu. Ft.

Dry Hole

Abandoned

Date

JUN 16 1948 19

S. J. LEWIS Scout