


Section 10 Township 21 Range 3 EWell No. # 5 MottCompany Mendenhall Drlg.

NORTH

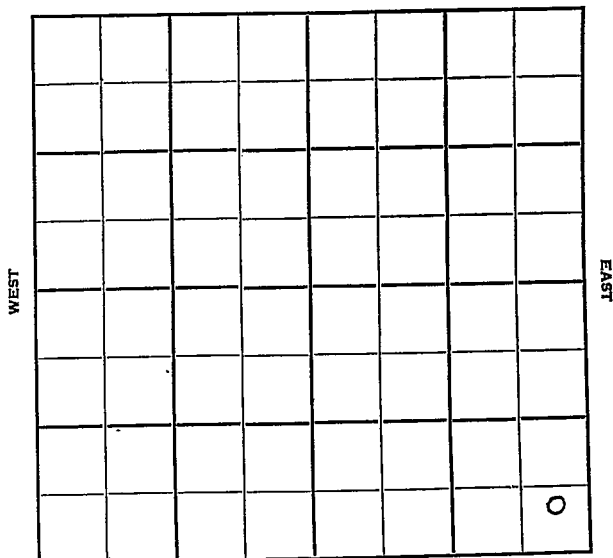

SOUTH

Marion

KANSAS

Sec. 10 Twp. 21 R. 3E

Well No. #5 Mott Farm

Mendenhall Drlg. Company

Contractor

Winger Pool

Ft. from N. Line

440'


Ft. from S. Line

330'

Ft. from E. Line

Ft. from W. Line

SE SE SE

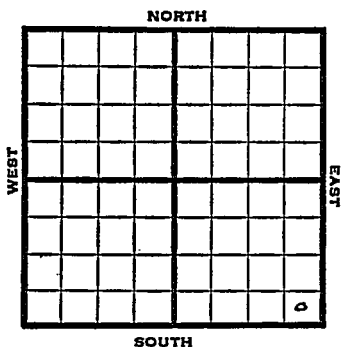

1951

Elev. -

REPORT

5/16

Spud 5-12-51

8" @ 64'

Drlg. 155'

5/29

Spud 5-12-51

Oil Well TD 2790

8" @ 64'

Miss 2484 Kinderhook 2622

Chatanooga 2775 Misenor 2783

Hunton 2786

5" @ 2787 TD 2790 FU 150' oil 150'


wtr 12 hr. 300 A

Comp. 35 hopd 50 bw

COMPLETED

J. E. TYRA

County Marion State Kansas
 Sec. 10 (Blk. 21) (Sur. 3E) Map No. _____
 Operator Mendenhall Drlg.
 Well No. 5 Farm Mott
 Elev. _____ Location SE SE SE

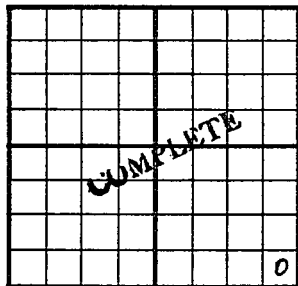

440 Ft. From S Line SE
330 Ft. From E Line Quarter
 Ist. Report _____
 Completion MAY 29 1951
 Remarks Winger Pool
 Spudding Date 5-12-51

Drlg. Data Oil well TD 2790
8" @ 64 Miss. 2484 Kinderhook 2622
Chatanooga 2775 Misenor 2783 Hunton 2786
5" @ 2787 TD 2790 FU 150' oil 150'
water 12 hr. 300 A Comp. 35 bopd 50bw

J. E. TYRA