

Map No. **KANSAS** Sec. 10 Twp. 27 R. 4

Well No. 1 - Moore Farm

Well No. _____
Fancher - Beeport Company

WEST

EAST

SOUTH

Rig Up.....
Drilling Remarks

RECORD

Cased.....in.....ft.

Sand.....

Gas.....

Oil.....

Total Depth.....

PRODUCTION

1st 24 hrs. Nat.....

1st 24 hrs. after shot.....

Gas.....cu. ft.-----

Dry Hole.....

Abandoned.....

Map No. Sec. Twp. R.

Well No. Farm


..... Company

..... Ft. from N. Line

..... Ft. from S. Line

..... Ft. from E. Line

..... Ft. from W. Line

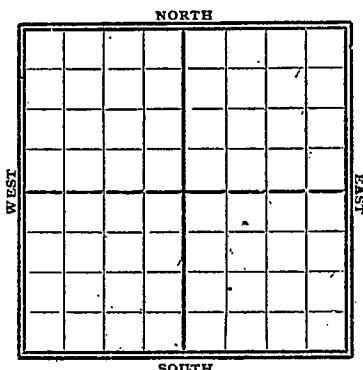

1922

Date

REPORT

Gypsy Record

11/9

Abd T'D 2630'

MAP No. _____ SEC. 10 TWP. 71S R. 4EWELL No. 1 MooreAnchor-Bellport COMPANY_____
CONTRACTOR

SECTION PLAT

		0	

FT. FROM N. LINE_____
FT. FROM S. LINE_____
FT. FROM E. LINE_____
FT. FROM W. LINENo Report

RECORD

LOCATION _____

CASED _____ IN. _____ FT.

RIG UP _____

SAND _____

DRILLING AND REMARKS:

GAS _____

OIL _____

TOTAL DEPTH No 50

PRODUCTION

1ST 24 HRS. NAT. _____

1ST 24 HRS. AFTER SHOT _____

GAS _____ CU. FT.

DRY HOLE ☒ABANDONED ☒

DATE

11/9 192 ✓ SCOUTno heat
in
pills