

Marion


KANSAS

SECTION 11 TOWNSHIP 21 RANGE 2E

WELL NO. #2 Brewer

COMPANY Anderson & Pritchard

NORTH

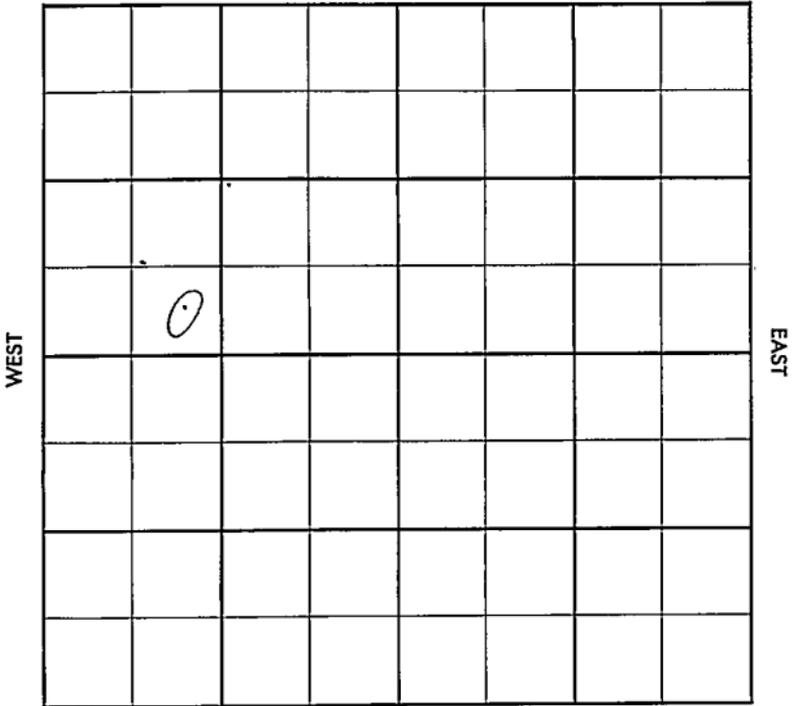

SOUTH

County Marion Elev. \_\_\_\_\_  
 Sec. 11 Twp. 21 Rgs. 2E  
 Company Anderson & Pritchard  
 Farm Name Brewer No. 2

TOPS	DEPTH	LOG	DATUM
Anh.			
Tp.			
H.			
Tr.			
Dg.			
Bl.			
L.			
K.C.			
B.K.C.			
Ce.			
C.			
M.			
M.			
K.			
Mz.			
Mo.			
V.			
S.			
S.			
A.			
R.			
Pe.			
G.			
Tp.			

Loc. in Sec. SE SW NW


Geol. \_\_\_\_\_

Contr. \_\_\_\_\_

Peel Tools

Pool: \_\_\_\_\_

Wildcat

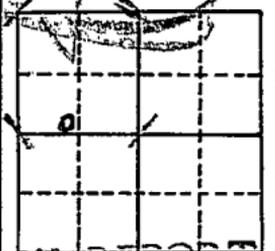

FIRST REPORT

Date Comm. MIRT Drlg. 2462 OCT 10 56

OCT 5 1956

Co.  
Lse.  
No.  
Sec.  
T.  
R.

Co.

County Marion Elev. 1478  
 Sec. 11 Twp. 21 Rgs. 2E  
 Company Anderson & Pritchard  
 FarmName Brewer No. 2

TOPS	DEPTH	LOG	DATUM	Loc. in Sec.
Ant.				SE SW NW
Sp.				
H.				
Tr.				
Dg.				
Bl.				
L.				
K.C.				Geol.
B.K.C.				Contr.
Ce.				
C.	2651	2650		Peel Tools
M.	2658	2656		
M.				Pool
K.	2718	2717		Wildcat
Mz. <u>Hunt</u>	2873	2872		
Ma. <u>sk</u>	2894	2893		
V.	2932	2930		
S.				
S.				
A.				
R.				
PE.				
G.				
T.D.	2950			

Loc.

No.

Sec.

T.

R.

OCT 17 1956  
 ABANDONED

Date Comm. MIRT Drlg. 2462 Oct 17 56 10-5-56 8578  
126 / DST 2876-85. 1 in new  
35' Md FP - 20-30 BHP 440

DEAR