

Map No. **KANSAS** Sec. 11 Twp. 21 S 4 E R

Well No. 1 - Smith Farm

Phillips Pet Company

NORTH

WEST

EAST

					0		

SOUTH

Location.....

Drilling Remarks

.....

.....

Rig Up.....

Drilling Remarks

.....

.....

RECORD

Cased..... in..... ft.

Sand.....

Gas.....

Oil.....

Total Depth.....

PRODUCTION

1st 24 hrs. Nat.....

1st 24 hrs. after shot.....

Gas..... cu. ft.....

Dry Hole.....

Abandoned.....

Map No. Sec. Twp. R.

Well No. Farm


..... Company

..... Ft. from N. Line

..... Ft. from S. Line

..... Ft. from E. Line

..... Ft. from W. Line

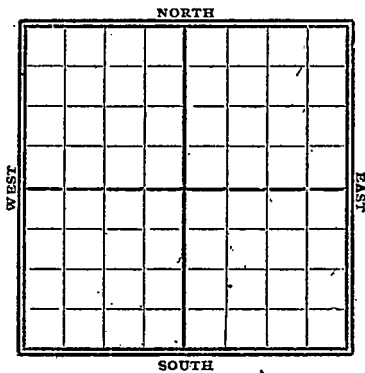

1922

Date

REPORT

Gypsy Records

3/20

Ord TD 2642'

MAP No. _____ SEC. 11 TWP. 21S R. 1E

WELL No. 1 Smith
Phillips Pet COMPANY

CONTRACTOR _____

SECTION PLAT

		0	

_____ FT. FROM N. LINE
 _____ FT. FROM S. LINE
 _____ FT. FROM E. LINE
 _____ FT. FROM W. LINE

No Record

RECORD

LOCATION _____

CASED _____ IN. _____ FT.

RIG UP _____

SAND _____

DRILLING AND REMARKS:

GAS _____

nothing in file

OIL _____

TOTAL DEPTH. 76 1/2

PRODUCTION

1ST 24 HRS. NAT. _____

1ST 24 HRS. AFTER SHOT _____

GAS _____ CU. FT.

DRY HOLE —

ABANDONED —

DATE

3/20 192 ✓

SCOUT