


KANSAS

Section 11 Township 21 Range 3E

Well No. 4 Wenger

Company B. Branine & Goering  
Wenger Pool

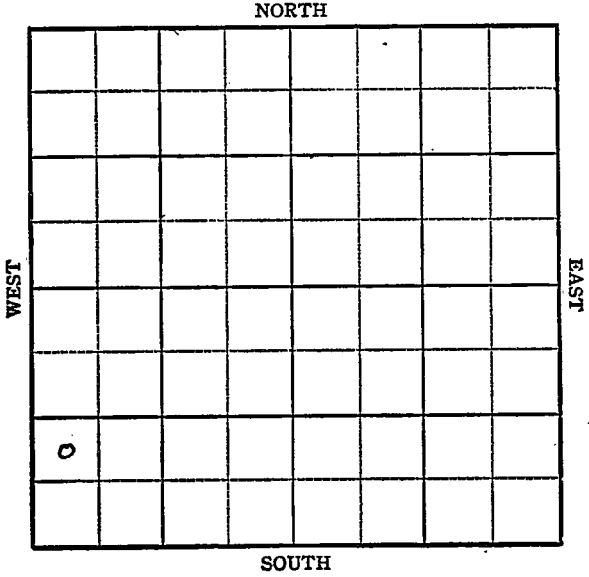

KANSAS

Marion



Sec. 11 Twp. 21 R. 3E

Well No. #4 Wenger Farm  
Branine & Goering Company

Wenger Pool


\_\_\_\_\_ Ft. from N. Line

990' Ft. from S. Line

\_\_\_\_\_ Ft. from E. Line

330' Ft. from W. Line

NW SW SW

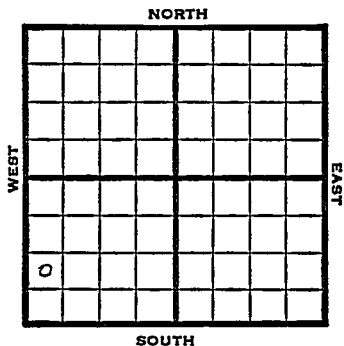

1948

E lev 1406' REPORT

12/8

Location

12/14

"

12/22

8" @102'  
Drlg. 1605'

12/29

Miss 2481'  
Hunton 2791'  
TD 2794'  
5" @ 2794'

1949

1/12

TD 2801'  
Hunton 2791'  
5" @ 2794'  
1000 acid  
Pump 55 Oil Pot  
38° Gr.

Gomp  
**COMPLETED**

Map No. \_\_\_\_\_ Sec. 11 Twp. 21 R. 3E

Well No. 4 Wenger

Brañine & Goering Company

FIRST REPORT Contractor

NW SW SW

**SECTION PLAT**

\_\_\_\_\_ Ft. from N. Line

990 Ft. from S. Line

\_\_\_\_\_ Ft. from E. Line

330 Ft. from W. Line

△			

Marion County

Location X

Rig up \_\_\_\_\_

Drilling and Remarks:

**RECORD**

Cased \_\_\_\_\_ in., \_\_\_\_\_ ft.

Sand \_\_\_\_\_

Gas \_\_\_\_\_

Oil \_\_\_\_\_

Total Depth \_\_\_\_\_

**PRODUCTION**

1st 24 hrs. Nat. \_\_\_\_\_

1st 24 hrs. after shot \_\_\_\_\_

Gas \_\_\_\_\_ Cu. Ft.

Dry Hole \_\_\_\_\_

Abandoned \_\_\_\_\_

Date

DEC 8 1948 19 S. J. LEWIS Scout

Map No. 24 Sec. 11 Twp. 21 R. 3E

Well No. 4 Wenger

Branine & Goering Company

**COMPLETE**

Contractor

*E. J. 1406*

**SECTION PLAT**

NW SW SW

\_\_\_\_\_ Ft. from N. Line

990 Ft. from S. Line

\_\_\_\_\_ Ft. from E. Line

330 Ft. from W. Line

U			

Marion County

**RECORD**

Location \_\_\_\_\_

Cased \_\_\_\_\_ in., \_\_\_\_\_ ft.

Rig up \_\_\_\_\_

Sand \_\_\_\_\_

Drilling and Remarks:

Gas \_\_\_\_\_

*Hunter 2791*

Oil \_\_\_\_\_

*5' @ 2794*

Total Depth 2801

*1000 @ 2801*

*Run 5500 @ 2801*

**PRODUCTION**

1st 24 hrs. Nat. \_\_\_\_\_

1st 24 hrs. after shot \_\_\_\_\_

Gas \_\_\_\_\_ Cu. Ft.

Dry Hole \_\_\_\_\_

Abandoned \_\_\_\_\_

*382 @ 2801*

Date

JAN 12 1949 19

S. J. LEWIS Scout