


Map No. 1 Sec. 1 Twp. 21 R. 12
 Well No. 1 Brewer Farm
Pryor & Lockhart Company

NORTH

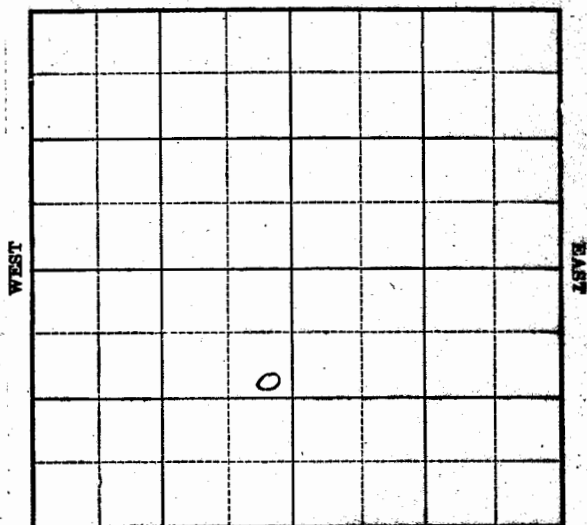

SOUTH

Location _____

Drilling Remarks:

Rig up _____

Drilling Remarks:

RECORD

Cased _____ in. _____ ft.

Sand _____

Gas _____

Oil _____

Total Depth _____

PRODUCTION

1st 24 hrs Nat. _____

1st 24 hrs. after shot _____

Gas _____ cu. ft.

Dry Hole _____

Abandoned _____

Map No. _____ Sec. 1 Twp. 21 R. 12
 Well No. 1 Brewer Farm
Pryor & Lockhart Company


1020 Ft. from N. Line

_____ Ft. from S. Line

300 Ft. from E. Line

_____ Ft. from W. Line

NORTH

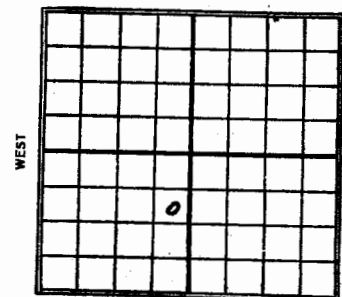

SOUTH

Date

1923

REPORT

7/16Location.8/48/29Top Line 1880and A. 1935

Map No. **KANSAS** Sec. **1** Twp. **21** R. **12**
 Well No. **1** **Brewer**
Pryor & Lockhart Company
 Contractor

ABANDONED SECTION PLAT

1020 Ft. from N. Line
 _____ Ft. from S. Line
300 Ft. from E. Line
 _____ Ft. from W. Line

Location _____

Rig up _____

Drilling and Remarks:

Tap Line 1880
1040 1935

RECORD

Cased _____ in., _____ ft.
 Sand _____
 Gas _____
 Oil _____
 Total Depth _____

PRODUCTION

1st 24 hrs. Nat. _____
 1st 24 hrs. after shot _____
 Gas _____ Cu. Ft.
 Dry Hole _____
 Abandoned _____

Date

SEP 29 1923

M. A. BENEAR

192

Scout

Map No. **KANSAS** Sec. **21** Twp. **21** R. **12**
 Well No. **1** **Brewer**
Pryor & Lockhart Company
 Contractor

FIRST REPORT**SECTION PLAT**

1020 Ft. from N. Line
 _____ Ft. from S. Line
300 Ft. from E. Line
 _____ Ft. from W. Line

Location _____

Rig up _____

Drilling and Remarks:

RECORD

Cased _____ in., _____ ft.
 Sand _____
 Gas _____
 Oil _____
 Total Depth _____

PRODUCTION

1st 24 hrs. Nat. _____
 1st 24 hrs. after shot _____
 Gas _____ Cu. Ft.
 Dry Hole _____
 Abandoned _____

Date

JUL 16 1923**M. A. BENEAR**

Scout