


DX 78-1 Lyons

KANSAS

Section 31 Township 21 Range 12E
 Well No. #2 Harlan
 Company Peter Schraag

NORTH

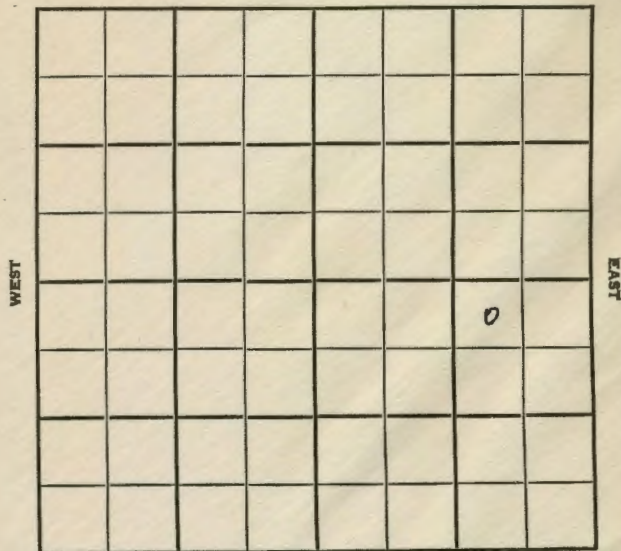

SOUTH

Lyons KANSAS

SEC.

TWP.

R.

31

21

12E

WELL NO.

2 Harlan

FARM

COMPANY

Peter Schraag

CONTRACTOR

 White & Ellis
 Frankhowser Pool

495

Ft. from N. Line


Ft. from S. Line

990

Ft. from E. Line

Ft. from W. Line

NORTH

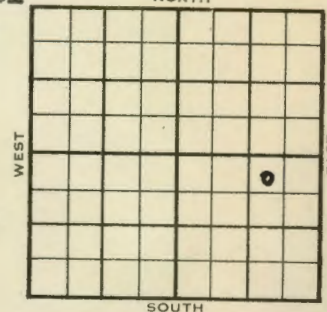

SOUTH

C W/2 NW NE SE

1954

ELEVATION

REPORT

10/27

 Spud 10-19-54
 rlg. 1950'

12/15

 Spud 10-19-54 Oil well TD 1952
 8" @ 85 Lans 968 KC 1212

 Bart 1895 TD 1952 5" @ 1935 frac.
 F/10 to 15 BO P/70 BO
 Comp. 70 BOPD

COMPLETED

DX-78

County	Lyons	State	Kansas	
Sec.	31	(Blk. Twp.)	21 (Sur. Rge.) 12E Map No.	
Operator	Peter G. Schraag	
Well No.	2	Farm	Harlan	
Elev.	Location C W $\frac{1}{2}$ NW NE SE	
<table border="1" style="border-collapse: collapse; text-align: center; width: 200px; height: 150px;"> <tr><td></td><td></td><td></td><td></td><td></td><td></td></tr> <tr><td></td><td></td><td></td><td></td><td></td><td></td></tr> <tr><td></td><td></td><td></td><td></td><td></td><td></td></tr> <tr><td></td><td></td><td></td><td></td><td></td><td></td></tr> <tr><td></td><td></td><td></td><td></td><td></td><td></td></tr> <tr><td></td><td></td><td></td><td></td><td></td><td></td></tr> <tr><td></td><td></td><td></td><td></td><td></td><td></td></tr> <tr><td></td><td></td><td></td><td></td><td></td><td></td></tr> <tr><td></td><td></td><td></td><td></td><td></td><td></td></tr> <tr><td></td><td></td><td></td><td></td><td></td><td></td></tr> </table> 495 Ft. From N Line SE 990 Ft. From E Line Quarter Ist. Report Completion DEC 15 1954 Remarks Frankhowser Pool White & Ellis - Contr. Spudding Date 10-19-54	
Drlg. Data	Oil well	TD 1952	
8" @ 85	Lans. 968	KC 1212	Bart. 1895	
TD 1952	5" @ 1935	frac	F/ 10 to 15 bo	
P/ 70 bo	Comp. 70 bopd	

FABEN GILSTRAP

County **Lyons** State **Kansas**
 Sec. **31** (Blk. **21** (Sur. **12E** Map No.
 Operator **Peter Schraag**
 Well No. **2** Farm **Harlan**
 Elev. _____ Location **C W $\frac{1}{2}$ NW NE SE**
495 Ft. From **E** Line **SE**
990 Ft. From **E** Line Quarter
 Ist. Report **OCT 27 1954**
 Completion _____
 Remarks **White & Ellis - Contr.**
 Spudding Date **10-19-54**
 Drig. Data **Frankhouser Pool**
drig. 1950

FABEN GILSTRAP