


Lyon

KANSAS

Section 31 Township 21 Range 12E

Well No. #3 Neussen "A"

Company Pater G. Schrag

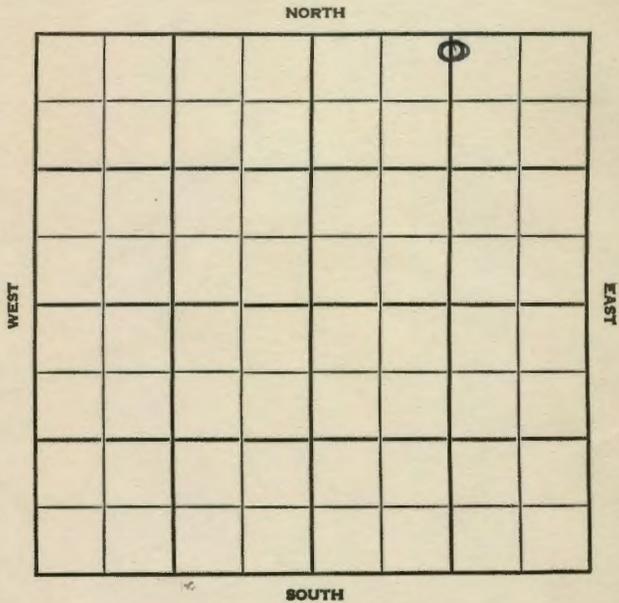

Lyon

KANSAS

SEC. 31 TWP. 21 R. 12E

WELL NO. #3 Neussen "A"

COMPANY Peter G. Schrag

CONTRACTOR White & Ellis


FRANKHOUSE

_____ Ft. from N. Line

_____ Ft. from S. Line

_____ Ft. from E. Line

_____ Ft. from W. Line

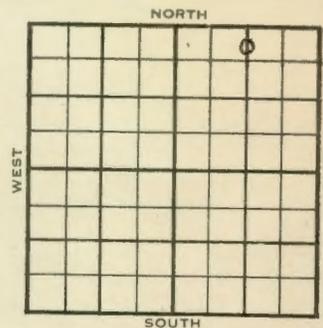

C N $\frac{1}{2}$ N $\frac{1}{2}$ NE
Frankhouse

1955 ELEVATION --- REPORT

6/22 Comm 6-19-55
8" @ 62
Drlg 277

7/13 Comm. 6-19-55
8" @ 62 5 $\frac{1}{2}$ " @ 1872
DD 1891 frac.
Comp. F/25 BOPD
KC 1151', Bart. 1874'
TD 1876'

COMPLETED

County Lyon Elev. _____
 Sec. 31 Twp. 21 Rge. 12E
 Company Peter G. Schrag
 FarmName Neussen "A" No. 3

TOPS	DEPTH	LOG	DATUM	Loc. in Sec.
Anh.				C N ¹ / ₂ N ¹ / ₂ NE
Tr.				
H.				
Tr.				
Dg.				
Bl.				
L.				Geol.
K.C.				Contr.
B.K.C. <u>ant</u>	<u>1651</u>			<u>White & Elli</u>
C.	<u>1874</u>			
M.				Pool
M.				
K.				
Mz.				
Me.				
V.				
S.				
S.				
A.				
R.				
Pe.				
G.				
TD.	<u>1876</u>			

0
 COMPLETE

Date Comm. 6-19-55 JUL 13 1955
8" @ 62 5¹/₂" @ 1872 DD 1891 frac
 Comp. P/ 25 bopd

County Lyon Elev. _____
 Sec. 31 Twp. 21 Rge. 12E
 Company Peter G. Schrag
 FarmName Neussen "A" No. 2

TOPS	DEPTH	LOG	DATUM	Loc. in Sec.
Anh.				C N ¹ / ₂ N ¹ / ₂ NE
Tr.				
H.				
Tr.				
Dg.				
Bl.				
L.				Geol.
K.C.				Contr.
B.K.C.				<u>White & Elli</u>
C.				
M.				Pool
M.				
K.				
Mz.				
Me.				
V.				
S.				
S.				
A.				
R.				
Pe.				
G.				
TD.				

φ
 FIRST REPORT
 JUN 22 '55

Date Comm. 6-19-55 Frankhouser
8" @ 62 drlg. 277

