

Lyon


KANSAS

Section 31 Township 21 Range 12E

Well No. 4 Neussen "A"

Company Peter G. Schrag

NORTH

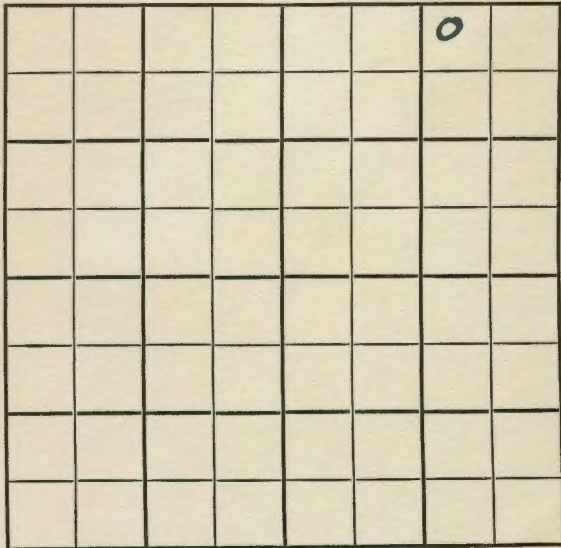

SOUTH

Lyon

KANSAS

SEC. 31	TWP. 21	R. 12E
---------	---------	--------

WELL NO. 4 Neussen "A" FARM

COMPANY Peter G. Schrag

CONTRACTOR Whire & Ellis Frankhouser

KANS

_____ Ft. from N. Line


_____ Ft. from S. Line

_____ Ft. from E. Line

_____ Ft. from W. Line

NW NE NE

NORTH

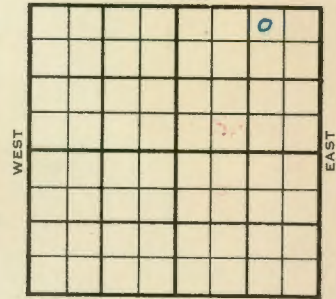

SOUTH

1955	ELEVATION	REPORT
------	-----------	--------

6/29 Comm 6-24-55
Bart 1884
 TD 1886
 8" @ 64
 5" @ 1885
 WOC

7/20 Comm 6-24-55
Bart 1884
 TD 1886
 8" @ 64 5" @ 1885 DD 1894
 25 bopd frac P/5 bopd Comp 50
 bopd

COMPLETED

County Lyon Elev. _____
 Sec. 31 Twp. 21 Rge. 12E
 Company Peter G. Schrag
 FarmName Neussen "A" No. 4

TOPS	DEPTH	LOG	DATUM	Loc. in Sec.																				
Anh.				NW NE NE																				
TP.																								
H.																								
Tr.																								
Dg.																								
Bl.																								
L.				Geol.																				
K.C.				Contr.																				
B.K.C.				<u>White & Elli</u>																				
Ce.				Pool																				
C.				<u>Frankhouser</u>																				
M.																								
M.																								
K.																								
Mz.																								
Me.																								
V.																								
S.	<u>Bart</u>	<u>1884</u>		<table border="1"> <tr><td></td><td></td><td></td><td></td></tr> <tr><td></td><td></td><td></td><td></td></tr> <tr><td></td><td></td><td></td><td></td></tr> <tr><td></td><td></td><td></td><td></td></tr> <tr><td></td><td></td><td></td><td></td></tr> </table>																				
S.																								
A.																								
R.																								
Pe.																								
G.																								
TD		<u>1886</u>																						

Date Comm. 6-24-55 JUL 20 1955
8" @ 64 5" @ 1885 DD 1894
25 bopd frac P/ 5 boph
Comp. 50 bopd

County Lyon Elev. _____
 Sec. 31 Twp. 21 Rge. 12E
 Company Peter G. Schrag
 FarmName Neussen "A" No. 4

TOPS	DEPTH	LOG	DATUM	Loc. in Sec.																				
Anh.				NW NE NE																				
TP.																								
H.																								
Tr.																								
Dg.																								
Bl.																								
L.				Geol.																				
K.C.				Contr.																				
B.K.C.				<u>White & Elli</u>																				
Ce.				Pool																				
C.				<u>Frankhouser</u>																				
M.																								
M.																								
K.																								
Mz.																								
Me.																								
V.																								
S.																								
S.	<u>Bart.</u>	<u>1884</u>		<table border="1"> <tr><td></td><td></td><td></td><td></td></tr> <tr><td></td><td></td><td></td><td></td></tr> <tr><td></td><td></td><td></td><td></td></tr> <tr><td></td><td></td><td></td><td></td></tr> <tr><td></td><td></td><td></td><td></td></tr> </table>																				
A.																								
R.																								
Pe.																								
G.																								
TD		<u>1886</u>																						

Date Comm. 6-24-55 JUN 29 '55
8" @ 64 5" @ 1885 WOC
FIRST REPORT