


Map No. KS Sec. 31 Twp. 21 R. 12 E
 Well No. 3-Jones Farm
W. H. Schwartz Company

NORTH

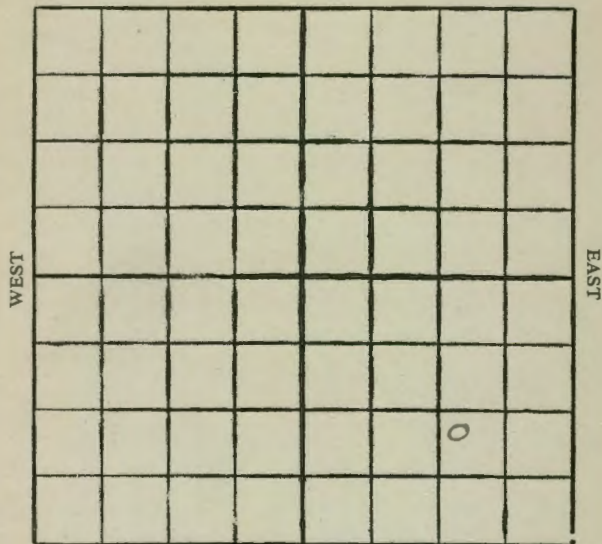

SOUTH

Location
 Drilling Remarks

Rig Up
 Drilling Remarks

RECORD


Cased in. ft.
 Sand
 Gas
 Oil
 Total Depth

PRODUCTION

1st 24 hrs. Nat.
 1st 24 hrs. after shot
 Gas cu. ft.
 Dry Hole
 Abandoned

Map No. Kansas Sec. 31 Twp. 21 R. 13
 Well No. 3 Jones Farm
W. H. Schwartz Company

NORTH

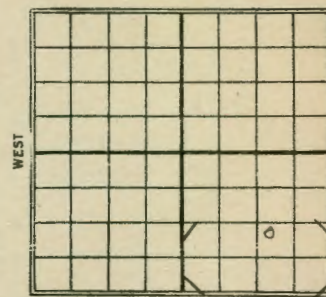

SOUTH

Ft. from N. Line

1120 Ft. from S. Line1120 Ft. from E. Line

Ft. from W. Line

Date

1927

REPORT

1/19Location1/26same2/3Timbers2/102/17Spudding4/24Drill 3503/2" 12003/9" 15503/16Top line 2020 D & A 2020

21 KANSAS

Map No. 31 Sec. 31 Twp. 21 R. 12 E

Well No. 3 Jones

W. H. Schwartz Company

Contractor

FIRST REPORTS

SECTION PLAT

Ft. from N. Line

1120 Ft. from S. Line

1120 Ft. from E. Line

Ft. from W. Line

Location ✓

Rig up

Drilling and Remarks:

RECORD

Cased in., ft.

Sand

Gas

Oil

Total Depth

PRODUCTION

1st 24 hrs. Nat.

1st 24 hrs. after shot

Gas Cu. Ft.

Dry Hole

Abandoned

Date

JAN 19 1927

CHAS. L. SHERWOOD

Scout

21 KANSAS

Map No. 31 Sec. 31 Twp. 21 R. 12

Well No. 3 Jones

W. H. Schwartz Company

Contractor

COMPLETED

SECTION PLAT

Ft. from N. Line

1120 Ft. from S. Line

1120 Ft. from E. Line

Ft. from W. Line

ABANDONED

Location

Rig up

Drilling and Remarks:

Top line 2020

2020

RECORD

Cased in., ft.

Sand

Gas

Oil

Total Depth 2020

PRODUCTION

1st 24 hrs. Nat.

1st 24 hrs. after shot

Gas Cu. Ft.

Dry Hole

Abandoned

Date

MAR 16 1927

CHAS. L. SHERWOOD

Scout