


Section 31 Township 21 Range 12-E

Well No. #2 Neussen

Company Warren E. Ellis

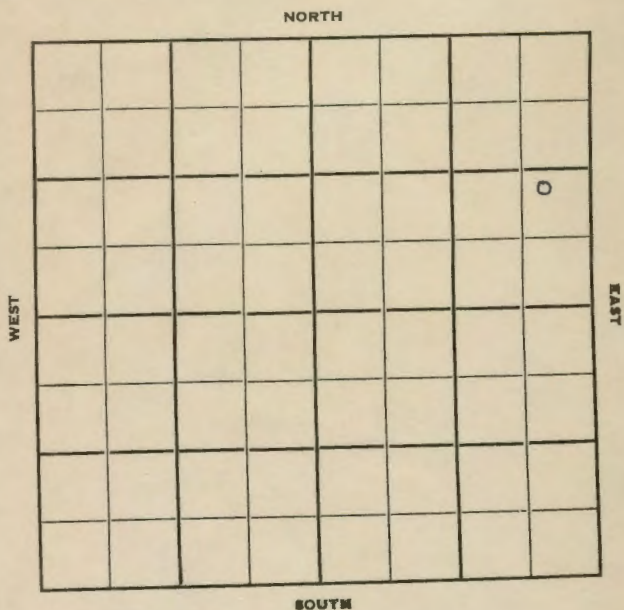

Sec. 31 Twp. 21 R. 12E

Well No. #2 Neussen Farm

Warren E. Ellis Company

Contractor


_____ Ft. from N. Line

1200' Ft. from S. Line

450' Ft. from E. Line

_____ Ft. from W. Line

NE SE NE

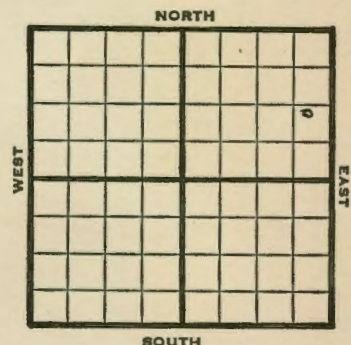

1950

REPORT

5/31 Spud 5-24-50
 8-5/8" @ 103'
 Bart 1909'
 TD 1910'
 5" @ 1909'
 WOC

6/14 8 5/8" @ 103
 Bart 1909
 TD 1951
 5" @ 1909
 100 qt. 1918-50
 Comp 50 bopd
 Completed

COMPLETED

Map No. _____ Sec. 31 Twp. 21 R. 12E

Well No. 2 Neussen

Warren E. Ellis Company

Contractor

NE SE NE

SECTION PLAT

_____ Ft. from N. Line
1200 Ft. from S. Line
450 Ft. from E. Line
 _____ Ft. from W. Line

			0
FIRST REPORT			

Lyon

Location _____

Rig up _____

Drilling and Remarks:

Spud 5-24-50
 8 5/8" @ 103
 Bart. 1909
 T. D. 1910
 5" @ 1909
 W. O. C.

RECORD

Cased _____ in., _____ ft.

Sand _____

Gas _____

Oil _____

Total Depth _____

PRODUCTION

1st 24 hrs. Nat. _____

1st 24 hrs. after shot _____

Gas _____ Cu. Ft.

Dry Hole _____

Abandoned _____

Date

MAY 31 1950 19 J. E. TYRA Scout

Kansas

Map No. _____ Sec. 31 Twp. 21 R. 12E

Well No. 2 Neussen

Warren E. Ellis Company

Contractor

NE SE NE

SECTION PLAT

_____ Ft. from N. Line
1200 Ft. from S. Line
450 Ft. from E. Line
 _____ Ft. from W. Line

			0
COMPLETE			

Lyon County

Location _____

Rig up _____

Drilling and Remarks:

8 5/8" @ 103
 Bart. 1909
 TD 1951
 5" @ 1909
 100 qt. 1918-50
 Comp. 50 bopd

RECORD

Cased _____ in., _____ ft.

Sand _____

Gas _____

Oil _____

Total Depth _____

PRODUCTION

1st 24 hrs. Nat. _____

1st 24 hrs. after shot _____

Gas _____ Cu. Ft.

Dry Hole _____

Abandoned _____

Date

JUN 14 1950 19 J. E. TYRA Scout