Marion


KANSAS

12 SECTION 21 TOWNSHIP 2E RANGE

#1 Hanneman WELL NO.

Anderson-Prichard Oil COMPANY

NW SW SW

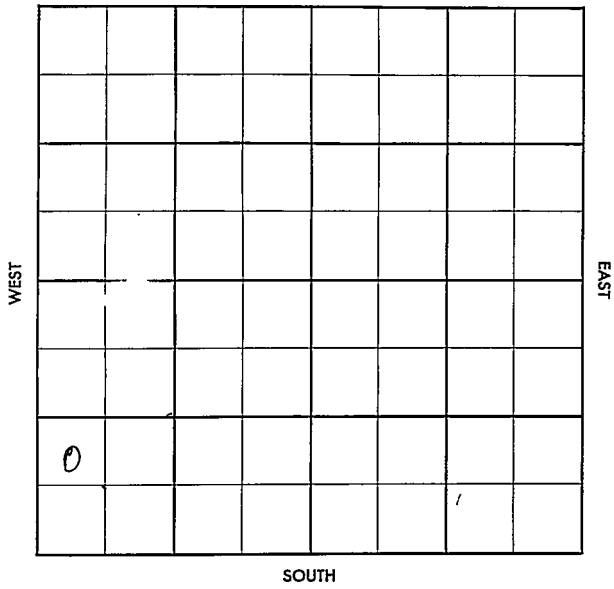

FORM 504-3 SUNRAY

FORM 513 SUNRAY

County Marion Elev.

Sec. 12 Twp. 21 Rge. 2E

Company Anderson-Prichard Oil

Farm Name Hanneman No. 1

TOPS	DEPTH	LOG	DATUM
Anh.			
T.P.			
H.			
Tr.			
Dg.			
B.L.			
L.			
K.C.			
B.K.C.			
Ce.			
C.			
M.			
M.			
K.			
Mz.			
Mq.			
V.			
S.			
S.			
A			
R.			
P€.			
G.			
T.D.			

Loc. in Sec. NW SW SW

Geol.

Contr. Glenn Peel Tts.

Pool Unger SW Ext.

FIRST REPORT

9 MAR 27 '57

Date Comm.

Location

Co.

No.

Sec.

T.

R.

FORM 513 SUNRAY

County Marion Elev. 1462

Sec. 12 Twp. 21 Rge. 2E

Company Anderson-Prichard Oil

Farm Name E. Hanneman No. 1

TOPS	DEPTH	LOG	DATUM
Anh.			
Tp.			
H.			
Tr.			
Dg.			
Bl.			
L.	2074		
K.C.			
B.K.C.			
Ce.			
C.			
M.	2637		
M. Li	2661		
K.	2718		
Mz. Hunt	2872		
Mq. shale	2888		
V.			
S.			
S.			
A			
R.			
PE.			
G.			
TD	2890		

Loc. in Sec. NW SW SW

Geol.

Contr. Glenn Peel Trs.

Pool Unger SW Ext.

MAY 1 '57

COMPLETE

Date Comm.

Location 3-28-57 8 5/8

12 1/15 5" ID 2260 APR 10 '57 DST

2867-77 30" rec 4' Mud

BHP 925 DST 2863-90 op

1hr 70' clean oil + 220' OCM

BHP 925/20" 5½ 2882/100

WOCT APR 17 '57 CO 2890 FU 500'

oil + 50' wtr 7 hrs Pot.

P 32 BO + 13 DW in 15 hrs

APR 24 '57 MAY 1 '57 P. 13 Bopd + 51 %o wtr