


Section 12 Township 21 Range 2E
Well No. #3 Taylor
Company Anderson-Pritchard

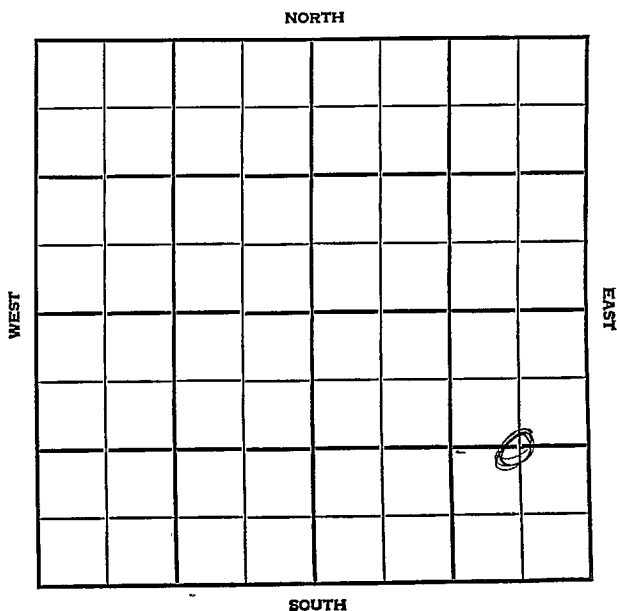

County Marion Elev. 1442
 Sec. 12 Twp. 21 Rge. 2E
 Company Anderson-Pritchard
 Farm Name Taylor No. 3

TOPS	DEPTH	LOG	DATUM
Anh.			
TP.			
H.			
Tr.			
Dg.			
BL.			
L.			
K.C.			
B.K.C.			
Ce.			
C.			
M.			
M.			
K.			
Mz.			
Mo.			
V.			
S.			
S.			
A.			
R.			
Pe.			
G.			
T.D.			

Loc. in Sec.

C E/2 SE

Geol.

Contr.

Glen Peel Toms

Pool

Unger

FIRST REPORT

Date Comm.

Celler Pitts

NOV 14 1956

County Marion Elev. 1442
 Sec. 12 Twp. 21 Rge. 2E
 Company Anderson-Pritchard
 Farm Name Taylor No. 3

TOPS	DEPTH	LOG	DATUM	Loc. in Sec.
Anh.				<u>C E/2 SE</u>
TP.				
H.				
Tc.				
Dg.				
BL.				
L.				
K.C.				Geol. _____
B.K.C.				Contr. _____
Ce.				<u>Glen Peel Tools</u>
C.				
M.		<u>2600</u>		
M.				Pool _____
K.		<u>2699</u>		<u>Unger</u>
Mz.				
Mo. <u>HUNT.</u>		<u>2854</u>		
V.		<u>2907</u>		
S.				
S.				
A.				
R.				
PE.				
G.				
TD.	<u>2940</u>			

ABANDONED
 NOV 29 '56

Date Comm.

Celler Pitts NOV 21 '56 11-15-56

878 @ 116 ID 2545 NOV 28 '56

DST 2837-55 1hr run 315'

Rot Md FP 70-140 BHP

975 DST 2839-55 90" run

65' Md + 780' SW FP 0 BHP

975

DEA