


Section 12 Township 21 Range 13 E

Well No. # 1 Finnerty

Company F. E. Lockhart & Geo. Waite

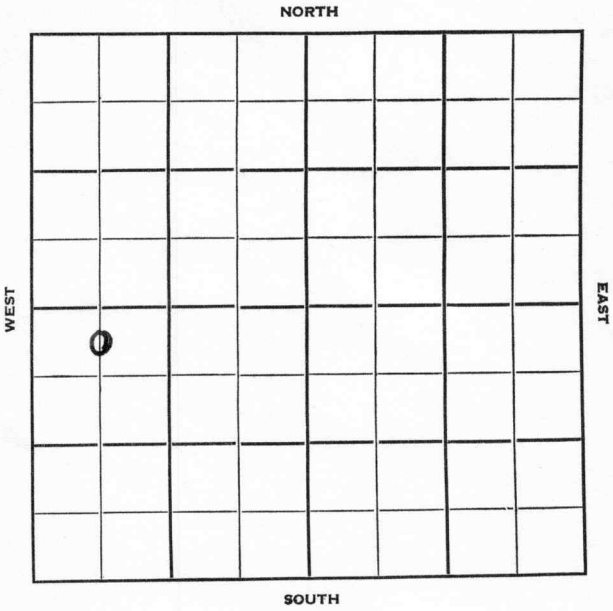

Sec. 12 Twp. 21 R. 13E

Well No. #1 Finnerty Farm

F.E. Lockhart & Geo. Waite Company

Earl Sauder Contractor

Wildcat.


330 Ft. from N. Line

_____ Ft. from S. Line

_____ Ft. from E. Line

660 Ft. from W. Line

C N L NW SW

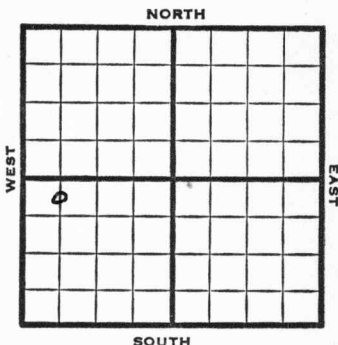

1953

Elev. 1129' REPORT

6/17

Squirrel sd 1391-96

1 goph

Burgess sd. 1728-34

TD

B/ 1 goph FU 290', 120' oil 9 hr.
5" @

7/29

Spud 6-3-53 Oil well TD 1739

Squirrel sd 1391-96 1 GOPH

Burgess sd 1728-34 B/1 BOPH

FU 390' 120' oil 9 hr. 5" @ 1730

CO to 1734 S/3/4 BOPH PB 1730

CO to 1734 3/4 BOPH DD 1736

DD 1739 S/3 1/4 BOPH Shut in 12 hrs.

FU 850' oil

Comp. 38 BOPD

COMPLETED

