
DX 78-1

Lyon KANSAS .

Section 12 Township 21 Range 10E

Well No. 1 Price

Company Petroleum, Inc.

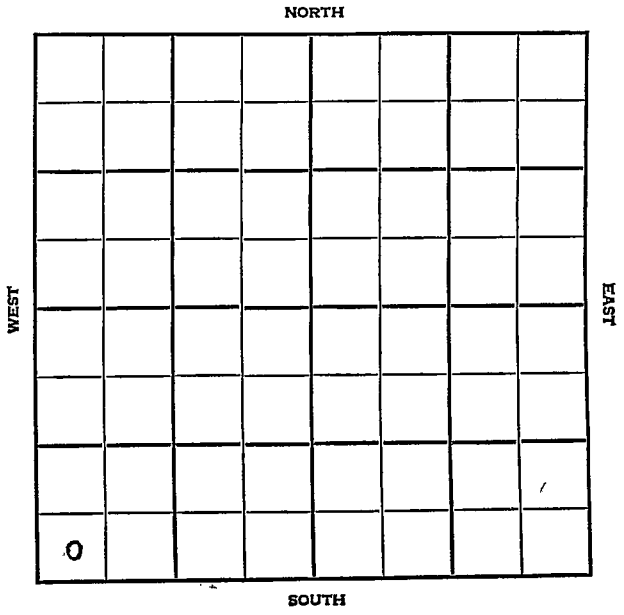

Lyon KANSAS

SEC.	TWP.	R.
12	21	10E

WELL NO. 1 Price FARM

COMPANY Petroleum, Inc.

CONTRACTOR Ward McGinnis

Bradfield Pool


_____ Ft. from N. Line

330 Ft. from S. Line

_____ Ft. from E. Line

330 Ft. from W. Line

SW SW SW

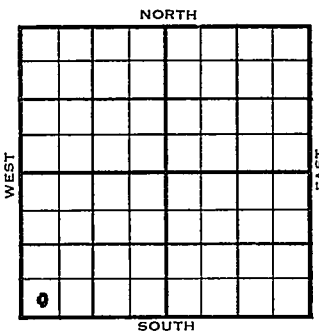

ELEVATION 1955	REPORT
3/9	MIR
3/23	Spud 3-8-55, D&A, TD 2634, KC 1286, Miss 2171, DST 1521-30 open 45 min. Rec 6' mud 505# DST 1353-85, open 1 hr Rec 755' SW, 330#, Viola 2587, DST 2561-95, open 1 hr Rec 4' mud 90#, DST 2543-2601 open 1 hr Rec 25' VSOCM 775#, TD 2634 D&A
	ABANDONED

DX-78

FORM 275 FOR SALE BY KANSAS BLUE PRINT CO.


County Lyon State Kansas

Sec. 12 (Blk. Twp.) 21 (Sur. Rge.) 10E Map No.

Operator Petroleum Inc.

Well No. 1 Farm Price

Elev. Location SW SW SW

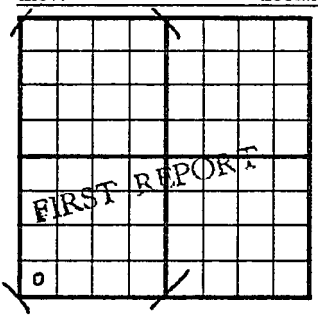

330 Ft. From S Line SW

330 Ft. From W Line Quarter

1st. Report MAR 9 1955

Completion

Remarks

Ward McGinnis - Contr.

Spudding Date

Drlg. Data Bradfield Pool

M I R

FABEN GILSTRAP

FORM 275 FOR SALE BY KANSAS BLUE PRINT CO.


County Lyon State Kansas

Sec. 12 (Blk. Twp.) 21 (Sur. Rge.) 10E Map No.

Operator Petroleum Inc.

Well No. 1 Farm Price

Elev. Location SW SW SW

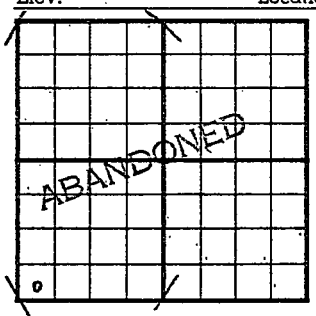

330 Ft. From S Line SW

330 Ft. From W Line Quarter

1st. Report

Completion MAR 2 3 1955

Remarks Bradfield Pool

Ward McGinnis - Contr.

Spudding Date 3-8-55

Drlg. Data D & A TD 2634

KC 1286 Miss. 2171 DST 1521-30

open 45 min. Rec. 6' mud 505#

DST 1353-85 open 1 hr. Rec. 755' sw

330# Viola 2587 DST 2561-95

open 1 hr. Rec. 4' mud 90#

DST 2543-2601 open 1 hr. Rec. 25' vsocm

775# TD 2634

D & A

FABEN GILSTRAP