


Chase ✓

Map No. *Kans* Sec. *13* Twp. *21* R. *9*

Well No. *1* *Dwens* Farm
C. L. Shedy et al Company

NORTH

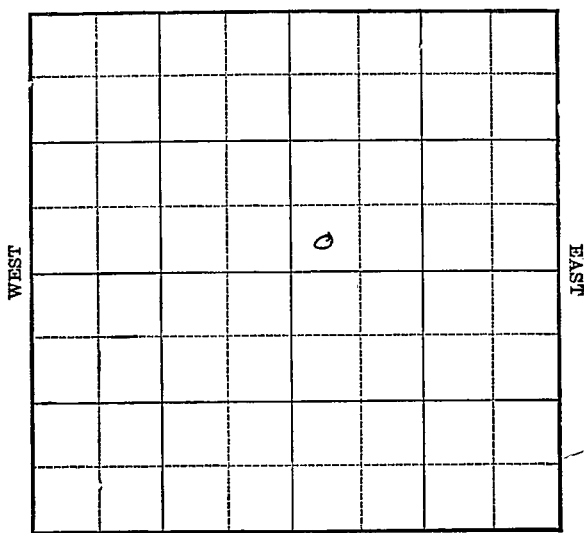

SOUTH

Location _____
 Drilling Remarks _____

Rig Up _____
 Drilling Remarks _____

RECORD

Cased _____ in. _____ ft.
 Sand _____
 Gas _____
 Oil _____
 Total Depth _____

PRODUCTION

1st 24 hrs. Nat. _____
 1st 24 hrs. after shot _____
 Gas _____ cu. ft.
 Dry Hole _____
 Abandoned _____

chase.

Map No. 17A/V Sec. 13 Twp. 21 R. 9Well No. 1 Owens Farm
C. L. Sheedy et al Company

NORTH


_____ Ft. from N. Line

330 Ft. from S. Line

_____ Ft. from E. Line

330 Ft. from W. Line

WEST

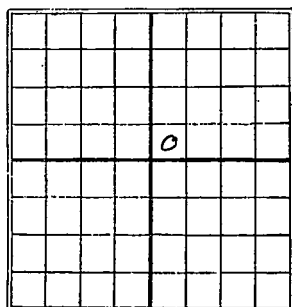

EAST

SOUTH

1926

Date

REPORT

7/28 Location
 8/4 Rig
 8/11 rigging up
 8/18 Dlg 620
 8/25 Drlg 1300
 8-31 ✓ 1820
 9/15- Bkwd 2300-09
 Top line 2414
 D & A. 2572

Choke Co
 K22 KANSAS
 Map No. _____ Sec. 13 Twp. 21 R. 9
 Well No. 1
 C. L. Sherwood et al owners
 _____ Company
 _____ Contractor

FIRST REPORTS

_____ Ft. from N. Line
 220
 _____ Ft. from S. Line
 _____ Ft. from E. Line
 220
 _____ Ft. from W. Line

SECTION PLAT

		o	

Location ✓ _____

Rig up _____

Drilling and Remarks:

RECORD

Cased _____ in., _____ ft.
 Sand _____
 Gas _____
 Oil _____
 Total Depth _____

PRODUCTION

1st 24 hrs. Nat. _____
 1st 24 hrs. after shot _____
 Gas _____ Cu. Ft.
 Dry Hole _____
 Abandoned _____

Date

JUL 28 1926

192

CHAS. L. SHERWOOD

Scout

Chase
 Map No. 22 KANSAS Sec. 13 Twp. 21 R. 9
 Well No. 1 Owens
C. L. Shedy Co. #4 Company
 Contractor

COMPLETED

SECTION PLAT

Ft. from N. Line

330 Ft. from S. Line

Ft. from E. Line

330 Ft. from W. Line

ABANDONED

Location _____

Rig up _____

Drilling and Remarks:

Broken ss 2300-09
Tap time 2414
10g
2572

RECORD

Cased _____ in., _____ ft.

Sand _____

Gas _____

Oil _____

Total Depth 2572

PRODUCTION

1st 24 hrs. Nat. _____

1st 24 hrs. after shot _____

Gas _____ Cu. Ft.

Dry Hole ☒Abandoned ☒

Date

SEP 15 1926

CHAS. L. SHERWOOD

Scout