


Section 13 Township 21 Range 4E

Well No. #1 Allison

Company Sam Springer

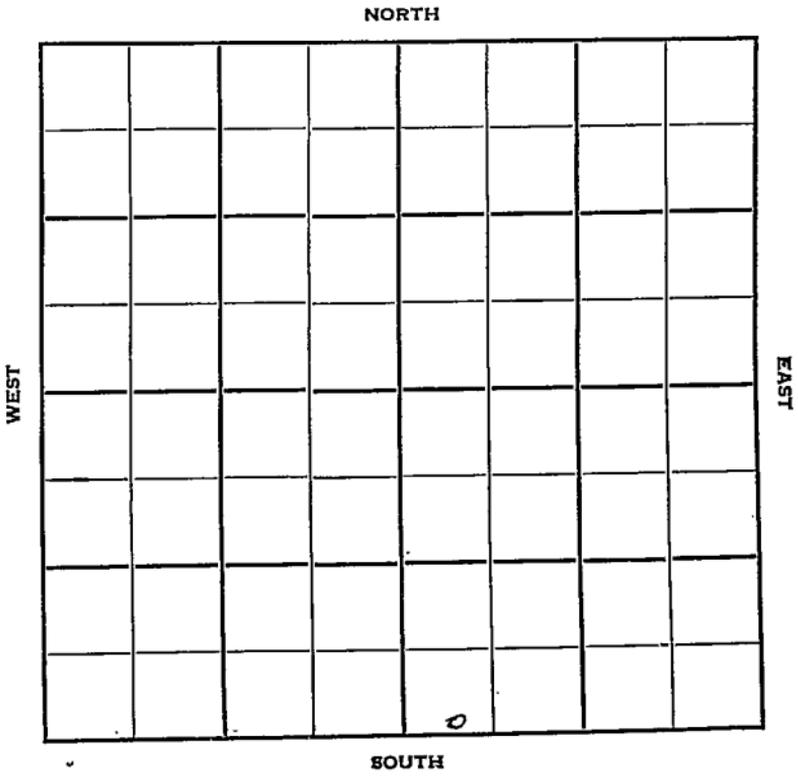

KANSAS

Marion ✓

Sec. 13 Twp. 21 R. 4-E

Well No. #1 Allison Farm

Sam Springer Company

Contractor


Florence Pool

 Ft. from N. Line

75 Ft. from S. Line

 Ft. from E. Line

330
~~990~~ Ft. from W. Line

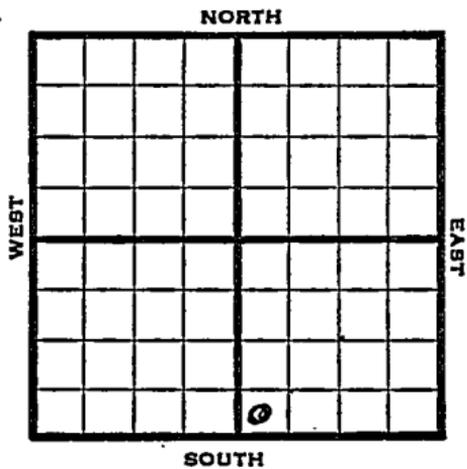

SW SW SE

1950 Elev 1351 REPORT

3/29 Spud 3-22-50
8" @ 175'
Miss 2195'
Drlg 2260'

5/17 TD 2743
8" @ 175
Miss 2195
5 1/2" @ 2390
Viola 2402
Simp 2499
Arb 2560
D&A

ABANDONED

Map No. _____ Sec. 13 Twp. 21 R. 4E

Well No. 1 Allison

Sam Springer Company

CORRECTION Contractor

SW SW SE


SECTION PLAT

_____ Ft. from N. Line

75 Ft. from S. Line

_____ Ft. from E. Line

330 Ft. from W. Line

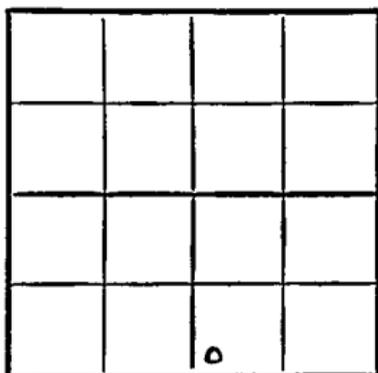

Marion County

Location _____

Rig up _____

Drilling and Remarks:

Reported
990 from W line

RECORD

Cased _____ in., _____ ft.

Sand _____

Gas _____

Oil _____

Total Depth _____

PRODUCTION

1st 24 hrs. Nat. _____

1st 24 hrs. after shot _____

Gas _____ Cu. Ft.

Dry Hole _____

Abandoned _____

Date

MAR 29 1950 19

J. E. TYRA
Scout






APR 5 1950

Scout Cards	<i>Caith</i>
Land Small Map	
Land Wall Map	<i>3</i>
Tracings	
France Map	
Pierce Map	
Misc	

Map No. _____ Sec. 13 Twp. 21 R. 4E

Well No. 1 Allison

Sam Springer Company

Contractor

SW SW SE 7

_____ Ft. from N. Line


75 Ft. from S. Line

_____ Ft. from E. Line

990 Ft. from W. Line

Marion County

SECTION PLAT

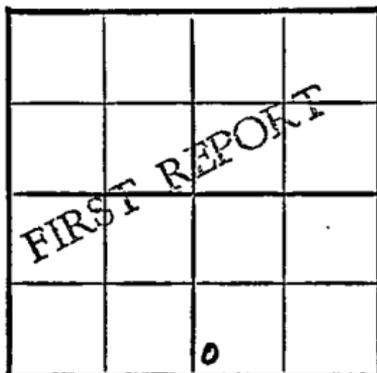

RECORD

Location _____

Rig up _____

Drilling and Remarks:

Spud 3-22-50

8" @ 175

Miss. 2195

drlg. 2260

Cased _____ in., _____ ft.

Sand _____

Gas _____

Oil _____

Total Depth _____

PRODUCTION

1st 24 hrs. Nat. _____

1st 24 hrs. after shot _____

Gas _____ Cu. Ft.

Dry Hole _____

Abandoned _____

Date

MAR 29 1950 19

J. E. TYRA Scout

Check feet measurements, spot and description

Advise

Sam

Scout Cards
Land Small Map
Land Wall Map
Tracings
France Map
Pierce Map
Misc.

APR 5

1950

Smith

Map No. _____ Sec. 13 Twp. 21 R. 4E

Well No. 1 Allison

Sam Springer Company

Contractor

SW SW SE


E1. 1351
SECTION PLAT

_____ Ft. from N. Line

100 Ft. from S. Line

_____ Ft. from E. Line

990 Ft. from W. Line

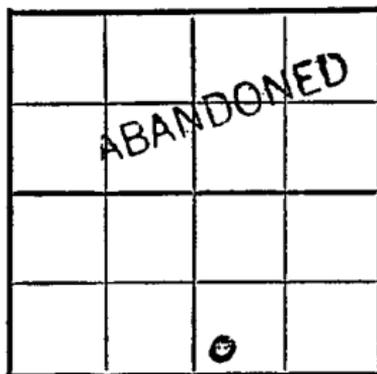

Marion

Location _____

Rig up _____

Drilling and Remarks:

*8' @ 175
miss 2195
5 1/2" @ 2390
Viola 2402
Simp 2499
Arb. 2560*

D & A

RECORD

Cased _____ in., _____ ft.

Sand _____

Gas _____

Oil _____

Total Depth 2743

PRODUCTION

1st 24 hrs. Nat. _____

1st 24 hrs. after shot _____

Gas _____ Cu. Ft.

Dry Hole _____

Abandoned _____

Date

MAY 17 1950

19

J. E. TYRA Scout

