


Map No. 15 Sec. 13 Twp. 21 R. 4
 Well No. 1 Allison Farm
C. L. Sheedy Company

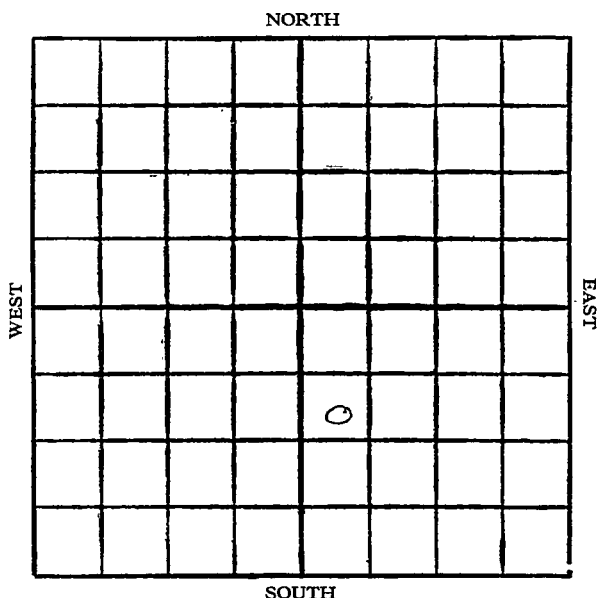

Location

Drilling Remarks

Rig Up.....

Drilling Remarks

RECORD

Cased.....in.ft.

Sand

Gas

Oil

Total Depth.....

PRODUCTION

1st 24 hrs. Nat.....

1st 24 hrs. after shot.....

Gas.....cu. ft.

Dry Hole.....

Abandoned.....


Map No. Kans Sec. 13 Twp. 21 R. 4
 Well No. 1 Allison Farm
C. L. Sheedy Company

990 Ft. from N. Line

_____ Ft. from S. Line

_____ Ft. from E. Line

330 Ft. from W. Line

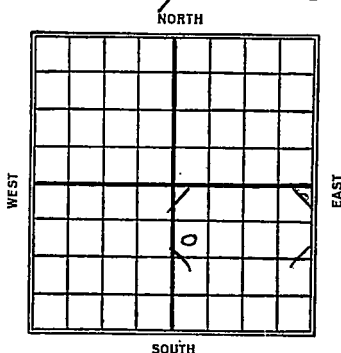

1926

Date

REPORT

10/27 Spudding

11/11 Drlg 320

11/17 S.D. 950

11/23 Drlg 980

12/8 S.D. 980 for 12" casing

12/15 same

12/22 _____

12/30 _____

1927

1/6 _____

1/13 _____

1/19 Drilling 1240

1/26 " 2100

2/3 " 2300

2/10 O. & A. 2363

Mallion
23 KANSAS *13* Sec. *21* Twp. *4* R.
 Map No. *1* Well No. *Alison*
C. L. Sherry Company

Contractor

FIRST REPORTS

SECTION PLAT

990 Ft. from N. Line
 _____ Ft. from S. Line
 _____ Ft. from E. Line
330 Ft. from W. Line

Location _____

Rig up _____

Drilling and Remarks:

Spudding

RECORD

Cased _____ in., _____ ft.

Sand _____

Gas _____

Oil _____

Total Depth _____

PRODUCTION

1st 24 hrs. Nat. _____

1st 24 hrs. after shot _____

Gas _____ Cu. Ft.

Dry Hole _____

Abandoned _____

Date

OCT 27 1926

CHAS. L. SHERWOOD

192

Scout

23 KANSAS Sec. 13 Twp. 21 R. 4
 Well No. 1 Harrison
 E. L. Sheedy Company

Contractor

COMPLETED

SECTION PLAT

990 Ft. from N. Line

Ft. from S. Line

Ft. from E. Line

330 Ft. from W. Line

		0	

ABANDONED

Location

Rig up

Drilling and Remarks:

DQH

2363

RECORD

Cased _____ in., _____ ft.

Sand _____

Gas _____

Oil _____

Total Depth 2263

PRODUCTION

1st 24 hrs. Nat. _____

1st 24 hrs. after shot _____

Gas _____ Cu. Ft.

Dry Hole ✓

Abandoned ✓

Date

FEB 10 1927

CHAS. L. SHERWOOD

192

Scout

MAP No. _____ SEC. 13 TWP. 21S R. 4EWELL No. 1 AlhansonChris Shedy COMPANY_____
CONTRACTOR

SECTION PLAT

Ft. FROM N. LINE_____
Ft. FROM S. LINE_____
Ft. FROM E. LINE_____
Ft. FROM W. LINE

LOCATION _____

RIG UP _____

DRILLING AND REMARKS:

OK
one well
7

RECORD

CASED _____ IN. _____ FT.

SAND _____

GAS _____

OIL _____

TOTAL DEPTH. 7363

PRODUCTION

1ST 24 HRS. NAT. _____

1ST 24 HRS. AFTER SHOT _____

GAS _____ CU. FT.

DRY HOLE ☒ABANDONED ☒

DATE

Feb 10 192 7 SCOUT