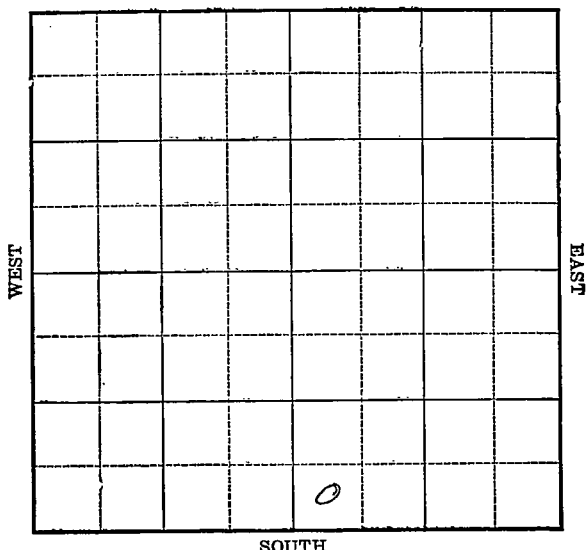


Marion

Map No. 17A5 Sec. 13 Twp. 21 R. 4Well No. 3 Allison FarmSheedy & Empire Company

NORTH

Location _____
Drilling Remarks _____Rig Up _____
Drilling Remarks _____

RECORD

Cased _____ in. _____ ft.

Sand _____

Gas _____

Oil _____

Total Depth _____

PRODUCTION

1st 24 hrs. Nat. _____

1st 24 hrs. after shot _____

Gas _____ cu. ft.

Dry Hole _____

Abandoned _____


Marion

Map No. Kansas Sec. 13 Twp. 21 R. 4Well No. 3 Allison FarmSheedy & Empire Company

_____ Ft. from N. Line

250 Ft. from S. Line

_____ Ft. from E. Line

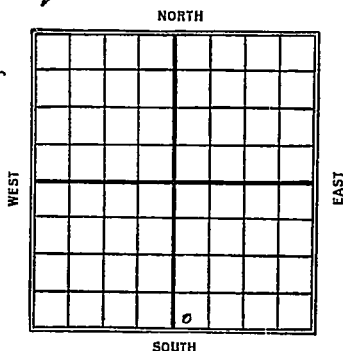250 Ft. from W. Line

Date

REPORT

19266/30 Location7/15 Rig7/22 Dlg 2107/28 " 12008/4 _____8/11 Dlg 21108/18 _____8/25 sand 2360-2361

300 bbls natural

T.O. 2361

K23 **KANSAS** Sec. 13 Twp. 21 R. 4
 Map No. _____
 Well No. 3 Allison
 Heedy & Enright Company
 Contractor

FIRST REPORTS

SECTION PLAT

Ft. from N. Line

250

Ft. from S. Line

Ft. from E. Line

250

Ft. from W. Line

		3	

Location ✓

Rig up

Drilling and Remarks:

RECORD

Cased _____ in., _____ ft.

Sand _____

Gas _____

Oil _____

Total Depth _____

PRODUCTION

1st 24 hrs. Nat. _____

1st 24 hrs. after shot _____

Gas _____ Cu. Ft.

Dry Hole _____

Abandoned _____

Date

JUN 30 1926

192

CHAS. L. SHERWOOD

Scout

23 KANSAS 13 21 4
 Map No. Sec. Twp. R.

Well No. 3 Allison
 Hardy & Empire Company

Contractor

COMPLETED

SECTION PLAT

Ft. from N. Line

250

Ft. from S. Line

Ft. from E. Line

250

Ft. from W. Line

		0	

Location

Rig up

Drilling and Remarks:

RECORD

Cased 1 in. ft.

Sand 2360-2361

Gas

Oil

Total Depth 2361

PRODUCTION

1st 24 hrs. Nat.

1st 24 hrs. after shot

Gas Cu. Ft.

Dry Hole

Abandoned

Date

AUG 25 1926

CHAS. L. SHERWOOD

192

Scout