


Section 13 Township 21 Range 4 EWell No. #1 SteinbuechelCompany Claude Shaft & Assoe.

NORTH

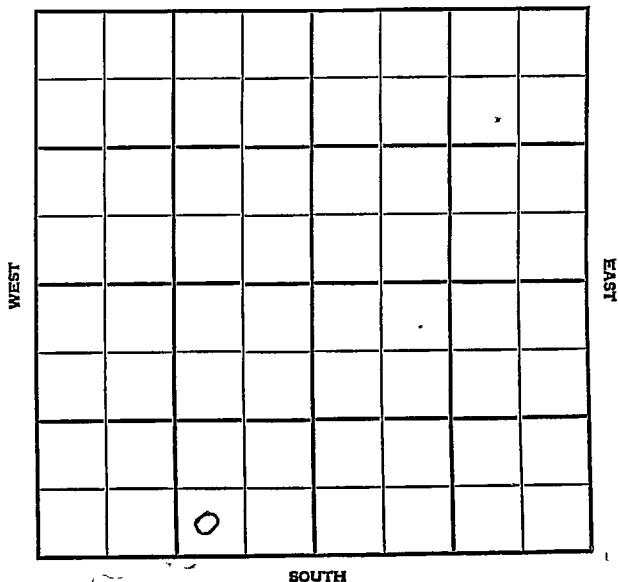

Marion

KANSAS

SEC.	TWP.	R.
13	21	4E

WELL NO.

#1 Steinbuchel

FARM

COMPANY

Claude Shaft & Assoc.

CONTRACTOR

Bedell & Catt

Florence

Ft. from N. Line

210


Ft. from S. Line

900

Ft. from E. Line

Ft. from W. Line

SW SE SW

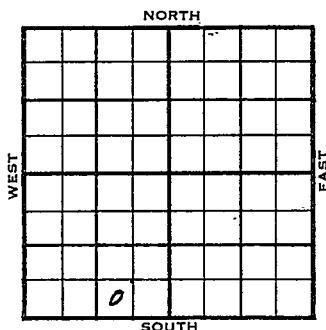

1956	ELEVATION	REPORT
	1291	
2-22	Old well abd. 8" @ 150 5" @ 2315 CO to 2319 B/225' oil 15 min, 10% wtr. DD 2325 B/10 go 30 min. DD 2328 Misener 2310 Hunton 2315 TD 2319 2328'	
4-18	DD 2339 4/2311-12, 200 A, frac D & A Miss. 2137 Chatta 2207 V. 2328 TD 2340'	
ABANDONED		

Co.

Use:

No.

505

六

र.

County Marion Elev. 1291Sec. 13 Twp. 21 Rge. 4ECompany Claude Shaft & Assoc.FarmName Steinbuechel No. 1

TOPS	DEPTH	LOG	DATUM	Loc. in Sec.
Anh.				SW SE SW
Tr.				210' SL
Dg.				900 EL
Bl.				Geol.
L.				Contr.
K.C.				Bedell & Cat
B.K.C.				Pool
Ce. <u>Miss</u>	<u>2137</u>		<u>846</u>	Florence
C. <u>Chatta</u>	<u>2207</u>		<u>916</u>	ABANDONED
M. <u>Meisner</u>	<u>2310</u>		<u>1019</u>	
M. <u>Huntton</u>	<u>2315</u>		<u>1024</u>	
K.				
Mz.				
Mq.				
V.	<u>2328</u>		<u>1037</u>	
S.				
S.				
A.				
R.				
PE.				
G.				
T.D.	<u>2340</u>			

Date Comm. APR 18 1956

8" @ 150 5" @ 2315 GO to 2319

B/ 225' oil in 15 min. 10% wtr.

DD 2325 B/ 10 go 30 min. DD 2328

DD 2339 4/ 2311-12 200 A frac

D & A