


DX 78-1 Marion

Section 13 Township 21S Range 2E
3E

Well No. #1 Abrahams

Company Anderson Prichard

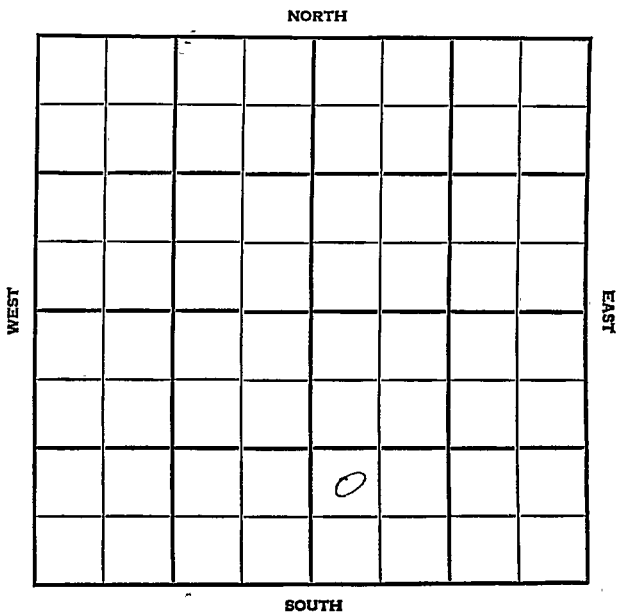

Marion

KANSAS

SEC.

TWP.

R.

13

21

3E 2E

WELL NO.

#1 Abrahams

FARM

COMPANY

Anderson Prichard

CONTRACTOR

Peel

Unger SW


_____ FT. FROM N. LINE

_____ FT. FROM S. LINE

_____ FT. FROM E. LINE

_____ FT. FROM W. LINE

NW SW SE

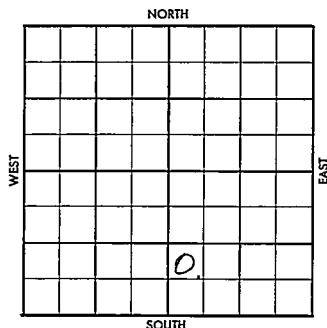

1956

ELEVATION

11467 RB

REPORT

8-29

Comm. 8-24-56
 10" @ 119 w/155
 Drlg. 2075'

9-6

Comm 8-24-56
 Tops:
 C 2444
 Chert 2695
 Li 2761
 K 2777
 Hunt 2924
 Mq 2950
 V 2992
 TD 3011
 10" @ 119 w/155
 D 2075
 D & A

ABANDONED

County Marion Elev. _____
Sec. 13 Twp. 21S Rge. 3E
Company Anderson Prichard
Farm Name Abrahams No. 1

TOPS	DEPTH	LOG	DATUM
Anh.			
Tp.			
H.			
Tr.			
Dg.			
BL.			
L.			
K.C.			
B.K.C.			
Ce.			
C.			
M.			
M.			
K.			
Mz.			
Me.			
V.			
S.			
S.			
A			
R.			
Pe.			
G.			
T.D.			

Loc. in Sec. _____
NW SW SE
DS S $\frac{1}{2}$ SE $\frac{1}{4}$
Geol. _____
Contr. _____
Peel
Pool _____
Unger SW

AUG 29 '36	
FIRST REPORT	
/ 0	

Date Comm. 8-24-56
10th 119 w/155; D 2075

[Handwritten signature and notes]

CORRECTION

FORM 513 SUNRAY

County Marion Elev. 146.7 R.B.
 Sec. 13 Twp. 21S Rge. 3E 2E
 Company Anderson Prichard
 Farm Name Abrahams No. 1

TOPS	DEPTH	LOG	DATUM
Anh.			
Tr.			
H.			
Tr.			
Dg.			
Bl.			
L.			
K.C.			
B.K.C.			
Ce.			
C.	2444		
M. chert	2695		
M. L.	2761		
K.	2777		
Mz. Hunt	2934		
Mq.	2950		
V.	2992		
S.			
S.			
A.			
R.			
Pe.			
G.			
T.D.	3011		

Loc. in Sec. NW SW SE
OS S $\frac{1}{2}$ SE $\frac{1}{4}$
 Geol. _____
 Contr. _____
Peel
 Pool _____
Unger SW
 ABANDONED
 SEP 5 '56
 0

Date Comm. 8-24-56
10" 119 w/155; D 2075 SEP 5 '56

D & A

Co.
Lse.
No.
Sec.
T.
R.