


DX 78-1 Marion

KANSAS

Section 13 Township 21 Range 2E

Well No. #1 Bartel

Company Anderson-Prichard

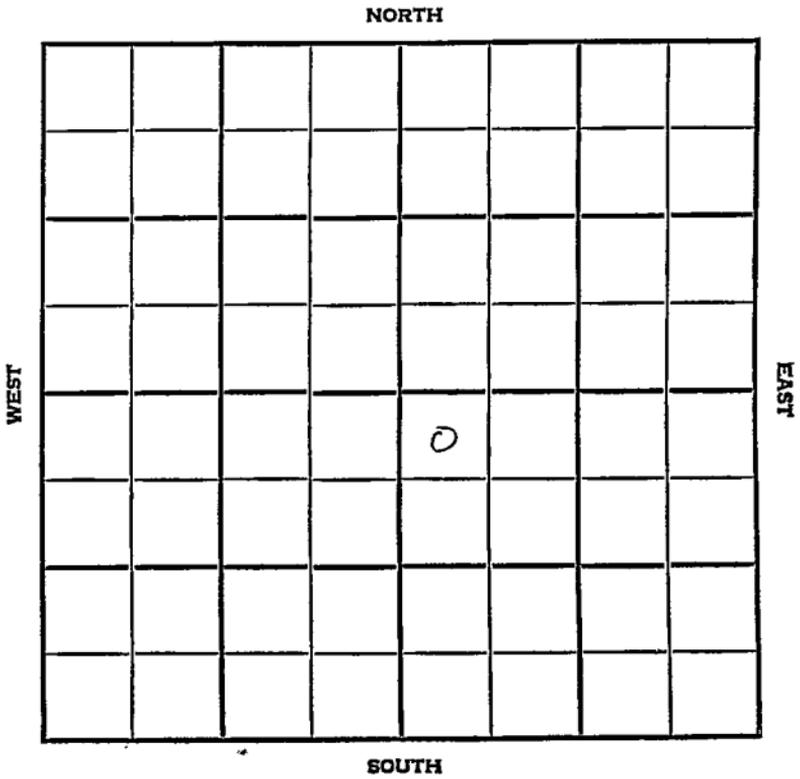

SEC. 13	TWP. 21	R. 2E
------------	------------	----------

WELL NO. #1 Bartel FARM

COMPANY Anderson - Prichard

CONTRACTOR Peel Bros.

SW Unger

\_\_\_\_\_ FT. FROM N. LINE

\_\_\_\_\_ FT. FROM S. LINE

\_\_\_\_\_ FT. FROM E. LINE

\_\_\_\_\_ FT. FROM W. LINE

NW NW SE

1956	ELEVATION 1458'	REPORT
------	--------------------	--------

7-18 Location

8-8 Comm. 7-19-56  
 8 5/8" @ 128 w/165  
 5 1/2" @ 2869 w/100  
 CO 2857 24/2847-53  
 FU 1745' oil, 5 hrs.  
 P/ 145 bopd, no/wtr.  
 Dg. sd. 1862'; L. 2066'; M. 2632';  
 M. Li. 2674'; K. 2698'; Hunt 2846';  
 Mq. 2854';  
 TD 2871' **COMPLETED**


County Marion Elev. \_\_\_\_\_  
 Sec. 13 Twp. 21 Rgs. 2E  
 Company Anderson-Prichard  
 Farm Name Bartel No. 1

TOPS	DEPTH	LOG	DATUM
Anh.			
TP.			
H.			
Tr.			
Dg.			
BL.			
L.			
K.C.			
B.K.C.			
Ce.			
C.			
M.			
M.			
K.			
Mz.			
Mq.			
V.			
S.			
S.			
A.			
R.			
PE.			
G.			
TD.			

Loc. in Sec. NW NW SE

Geol. \_\_\_\_\_  
Contr. Peel Bros.

Pool SW Unger

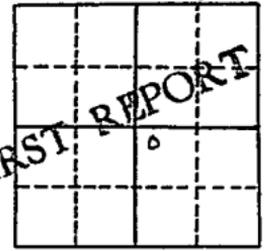

Date Comm. JUL 18 '56

Location

*[Handwritten signature]*

1956

R.C.

Co.  
No.  
Sec.  
T.  
R.

County Marion Elev. 1457  
 Sec. 13 Twp. 21 Rgs. 2D  
 Company Anderson-Prichard  
 Farm Name Hartel No. 1

TOPS	DEPTH	LOG	DATUM	Lot in Sec.
Anb.				
Ip.				
H.				
Tr.				
Dg. <u>sd</u>	<u>1862</u>			
Bl.				
L.	<u>2066</u>			
K.C.				Geol.
B.K.C.				Contr.
Ce.				Feel Desc.
C.				
M.	<u>2633</u>			Pool
M. <u>LI</u>	<u>2674</u>			<u>SI Unger</u>
K.	<u>2698</u>			
Mz. <u>Hurt</u>	<u>2844</u>			
Mo.	<u>2854</u>			
V.				
S.				
S.				
A.				COMPLETE
R.				
PE.				
G.				
TD.	<u>2871</u>			

Date Comm. AUG 8 '56  
 Location JUL 25 '56 7-19-56 8578128  
1165 ID 2565 AUG 1 '56 5 1/2 @ 2869  
1100 CO 2857 24/2847-53 FU  
1745' oil 5 hrs TOR  
AUG 8 '56 POP PH P. 145 BOPD  
no/water