


DX 78-1 Marion

KANSAS

Section 13 Township 21 Range 2E

Well No. #1 Eitzen

Company Leben Drlg

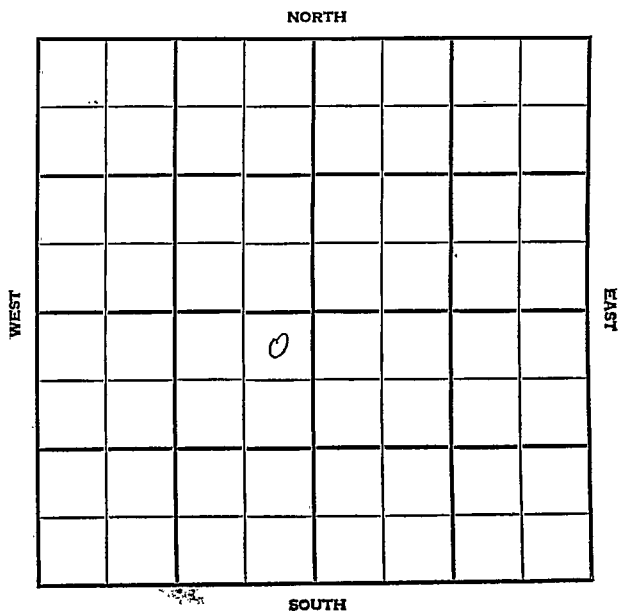

SEC. 13	TWP. 21	R. # 2E
------------	------------	------------

WELL NO.

#1 Eitzen

FARM

COMPANY

Leben Drlg.

CONTRACTOR

Unger Est.


_____ FT. FROM N. LINE

_____ FT. FROM S. LINE

_____ FT. FROM E. LINE

_____ FT. FROM W. LINE

NE NE SW

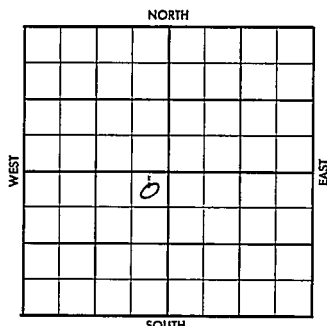

GSO - DHM

1956	ELEVATION	REPORT
5-29	8" @ 125 w/100	
8-8	5" @ 2910 Pf 12/2874-76 FU 1100' oil F/ 2150' oil P/ 192 BO, no/wtr., 15 hrs. P/ 109 BOPD no/wtr., Grav. 38 Mq. 2891'; TD 2911'	COMPLETED

County Marion Elev. _____
 Sec. 13 Twp. 21 Rge. 2E
 Company Leban Drlg.
 Farm Name Eitzen No. 1

TOPS	DEPTH	LOG	DATUM	Loc. in Sec.
Anh.				NE NE SW
TP.				
H.				
Tr.				
Dg.				
BL.				
L.				Geol.
K.C.				Contr.
B.K.C.				
Ce.				
C.				
M.				
M.				Pool
K.				Unger Est.
Mz.				
Me.				
V.				
S.				
S.				
A.				
R.				
PE.				
G.				
T.D.				

FIRST REPORT
 MAY 29 '55

Date Comm. _____ GSO & DHM

8" @ 125/100

Y. 0. 0. 0. 0.

County Marion Elev. 1000
 Sec. 13 Twp. 21 Rge. 2E
 Company Leben Drlr.
 Farm Name Etzen No. 1

TOPS	DEPTH	LOG	DATUM	Loc. in Sec.
Anh.				NE NE SW
Ep.				
H.				
Tr.				
Dg.				
Bl.				
L.				Geol.
K.C.				Contr.
B.K.C.				
Ce.				
C.				
M.				Poni
M.				Unger Ext.
K.				
Mz.				
Mo.	2891			
V.				
S.				
S.				
A.				
R.				
Pe.				
G.				
TD.	2911			

Date Comm.

GSO - DHM

8" @ 125/100

JUN 13 '56

JUN 13 '56

RTD 2911

5" 2910

pf 12/2874-76

FU 1100' oil

F 2150' oil JUN 20 '56

P. 192 B0

no/w 15 hrs JUN 27 '56

JUL 3 '56 ✓

JUL 11 '56 JUL 18 '56 JUL 25 '56 AUG 1 '56

AUG 8 '56

Ph P. 109 B0pd

no/w gran 38°