


Section 13 Township 21 Range 2E

Well No. #3 Bartel

Company Anderson-Pritchard

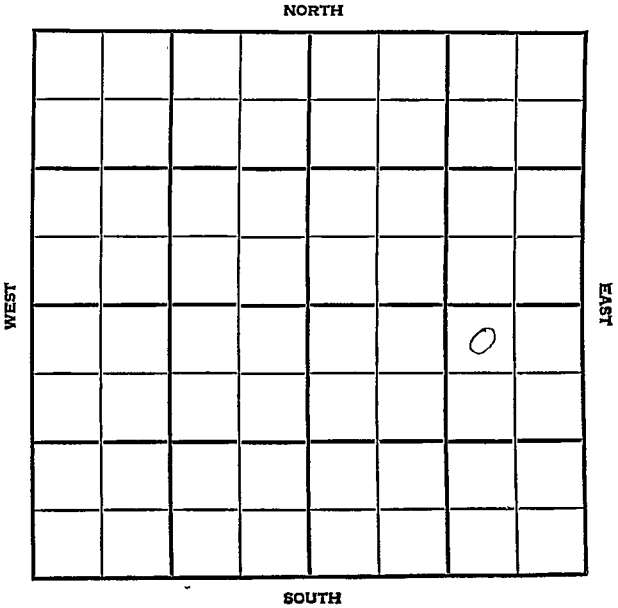

County Marion Elev. _____
 Sec. 13 Twp. 21 Rge. 2E
 Company Anderson-Pritchard
 Farm Name Bartel No. 3

TOPS	DEPTH	LOG	DATUM	Loc. in Sec.
Anh.				NW NE SE
Tr.				
H.				
Dg.				
Bl.				
L.				Geol.
K.C.				Contr.
B.K.C.				Glenn Peel
Ce.				Tools
C.				Pool
M.				Unger
M.				
K.				
Mz.				
Me.				
V.				
S.				
S.				
A.				
R.				
Pe.				
G.				
T.D.				

FIRST REPORT
 NOV 7 '55

Date Comm. WORT

2007-13 NOV

2.57

County Marion Elev. 146.2
 Sec. 13 Twp. 21 Rge. 2E
 Company Anderson-Pritchard
 FarmName Bartel No. 3

TOPS //	DEPTH	LOG	DATUM
Anb.			
Tr.			
H.			
Tr.			
Dg.			
BL.			
L.			
K.C.			
B.K.C.			
Ce.			
C.			
M.	2618		
M.			
K.	2682		
Mz. <u>Hunt</u>	2832		
Ma.	2843		
V.	2888		
S.	2948		
S.			
A.			
R.			
PE.			
G.			
TD.	2970	2972	

Loc. in Sec.
 NW NE SE


Geol.

Contr.

Glenn Peel
 TOOLS

Pool

Unger

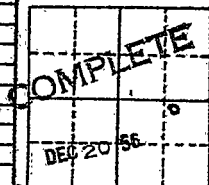

Date Comm.

WORT NOV 13 '56 11-11-56 8 5/8 116

1155 ID 130 NOV 21 '56 5 1/2 @ 2888

NOV 28 '56

CO 2854 40/2832-42

EU 2800' oil no/w 7 hrs Pop

P. 146 Bø no/w 17 hrs DEC 5 '56

P. 33 Bø no/w 5 hrs DEC 12 '56

DEC 19 '56

PH P. 149 Bø pd no/w

gran 38.5°